

22-4311

MISSISSIPPI DEPARTMENT OF NATURAL RESOURCES

Bureau of Land and Water Resources

COUNTY WELL LOCATED
Washington

WELL NUMBER **C65** CODED

DATE WELL COMPLETED
7-25-89

126 D or 146 B

PERMIT NUMBER

NAME OF DRILLING FIRM
Layne Central

Cleveland, MS

CODED

P.O. Box 10631
Jackson, Mississippi 39209
WATER WELL DRILLERS LOG

NAME & MAILING ADDRESS OF LANDOWNER
Beckham Farms

Rt 2, Box 133

Leland, MS 38756

WELL LOCATION: SEC **9** TOWNSHIP **19 N** RANGE **6 W**

DISTANCE **1/2** Miles **N** of **Helm**

OTHER LANDMARK

WELL PURPOSE: Home, Irrigation, Municipal, Industrial, Fish Pond, etc.

PUMP DATA

PUMP TYPE (Circle One):
Submersible, Turbine, Jet, Flowing Well,
Other (Describe)

POWER TYPE (Circle One):
Electric, Tractor, Diesel, Gasoline, Butane,
Other (Describe) **H/P 40**

Pump Capacity (GPM) **400** No. of Stages **5** Setting Depth **52 FT.**

PUMP TEST

Well yielded _____ GPM with
a drawdown of _____ ft.
after _____ hours of pumping

WELL DATA

Well Depth 118'	Casing Diameter (In.) 10	Casing Length (Ft.) 78
Type of Casing PVC	Hole Depth 118'	Depth to Static Water Level 21' 9"

TYPE OF COMPLETION: (Circle One or More):
Gravel Packed, Underreamed, Telescoped,
Natural Development, Open Hole, Other

Top of Lap Pipe or Reduction in Casing
N/A FEET IF TELESCOPED OR MORE THAN ONE SCREEN: USE BACK PAGE

LOG DATA

TYPE OF LOG RUN (Circle One): No Log Run
Electric, Gamma Ray, Density, Sonic, Neutron,
Other (Describe)

Name of Organization Running Log


SCREEN DATA

Diameter - Inches 10"	Length - Feet 40'	Slot Size - Inches .030
Screen Type PVC	Depth to Bottom - Feet 118	

GEOLOGIC DATA (Office Use Only)

Surface Elev.	Geologic Unit	Unit Thickness	Depth to Top
Subs. SWL	Date	Analysis	Aquifer Test

Driller's Remarks
Replaces old well
15' AWAY

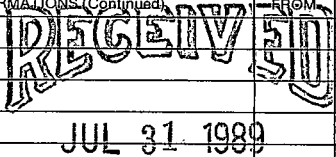
DESCRIPTION OF FORMATIONS ENCOUNTERED	FROM	TO	FORMATIONS (Continued)	FROM	TO
Clay	0	23			
Sand	23	50			
Med. Sand	50	70			
GRAVEL	70	118			
Clay	118				

Department of Natural Resources
Bureau of Land & Water Resources

IF MORE SPACE IS NEEDED, USE BACK

If well telescopes please
sketch and show depths.

GROUND LEVEL

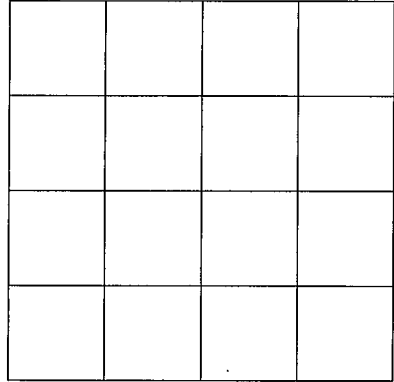

SECTION _____

Please indicate well location X.

ADDITIONAL INFORMATION

If more than one screen,
show location of each on sketch.
