

MISSISSIPPI DEPARTMENT OF ENVIRONMENTAL QUALITY

Office of Land and Water Resources

P. O. Box 10631
Jackson, MS 39289-0631
WATER WELL DRILLERS LOG

COUNTY WELL LOCATED <u>Washington</u>	
WELL NUMBER <u>C 71</u>	COD60
DATE WELL COMPLETED <u>Oct 12 1994</u>	

PERMIT NUMBER
NAME OF DRILLING FIRM <u>Schudco Ltd</u>

NAME & MAILING ADDRESS OF LANDOWNER <u>Reed Smeda</u> <u>Seland Drs 38756</u>		
WELL LOCATION: SEC	TOWNSHIP	RANGE
<u>33</u>	<u>19</u>	<u>6</u>
DISTANCE	DIRECTION	NEAREST TOWN
<u>5</u> Miles	<u>NE</u>	of <u>Leland</u>
OTHER LANDMARK		
WELL PURPOSE: <input checked="" type="checkbox"/> Home Irrigation, <input type="checkbox"/> Municipal, <input type="checkbox"/> Industrial, <input type="checkbox"/> Fish Pond, etc.		

PUMP DATA		
PUMP TYPE (Circle One): <input checked="" type="checkbox"/> Submersible, <input type="checkbox"/> Turbine, <input type="checkbox"/> Jet <input type="checkbox"/> Flowing Well, Other (Describe) _____		
POWER TYPE (Circle One): <input checked="" type="checkbox"/> Electric, <input type="checkbox"/> Tractor, <input type="checkbox"/> Diesel, <input type="checkbox"/> Gasoline, <input type="checkbox"/> Butane, Other (Describe) _____ H/P <u>3</u>		
Pump Capacity (GPM)	No. of Stages	Setting Depth
<u>55</u>		<u>105</u> FT.
PUMP TEST		
Well yielded _____ GPM with a drawdown of _____ ft. after _____ hours of pumping		

WELL DATA		
Well Depth <u>455</u>	Casing Diameter (In.) <u>4x3</u>	Casing Length (Fl.) <u>425</u>
Type of Casing <u>pvc</u>	Hole Depth <u>460</u>	Depth to Static Water Level <u>34</u>

LOG DATA	
TYPE OF LOG RUN (Circle One): <input checked="" type="checkbox"/> No Log Run, <input type="checkbox"/> Electric, <input type="checkbox"/> Gamma Ray, <input type="checkbox"/> Density, <input type="checkbox"/> Sonic, <input type="checkbox"/> Neutron, Other (Describe) _____	
Name of Organization Running Log	


TYPE OF COMPLETION: (Circle One or More):
 Gravel Packed, Underreamed, Telescoped,
 Natural Development, Open Hole, Other
 (Describe) _____

GEOLOGIC DATA (Office Use Only)			
Surface Elev.	Geologic Unit	Unit Thickness	Depth to Top
Subs. SWL	Date	Analysis	Aquifer Test

WELL GROUTED TO A DEPTH OF 25 FEET
 Type Grout (circle one): Cement, Bentonite or Mix

Driller's Remarks			



SCREEN DATA		
Diameter - Inches <u>3</u>	Length - Feet <u>30</u>	Slot Size - Inches <u>.010</u>
Screen Type <u>pvc</u>	Depth to Bottom - Feet <u>455</u>	

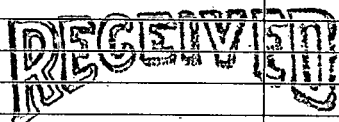DESCRIPTION OF FORMATIONS ENCOUNTERED	FROM	TO	FORMATIONS (Continued)	FROM	TO
<u>Top clay</u>	<u>0</u>	<u>8</u>	 JAN 11 1995 Dept. of Environmental Quality Office of Land & Water Resources		
<u>sand & gravel</u>	<u>8</u>	<u>178</u>			
<u>clay</u>	<u>178</u>	<u>340</u>			
<u>sand</u>	<u>340</u>	<u>460</u>			

IF MORE SPACE IS NEEDED, USE BACK

If well telescopes please sketch and show depths.

GROUND LEVEL

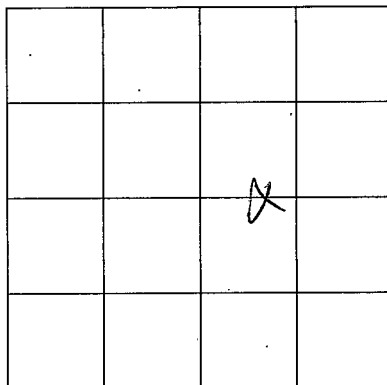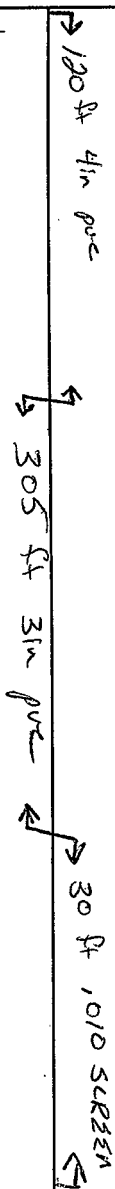

SECTION 33

Please indicate well location X.

ADDITIONAL INFORMATION

If more than one screen, show location of each on sketch.