County:Washington	State Well Report Part 1	For Office Use Only:
Permit#: <u>10 599999</u> Irrigation Equipment Driller:	Mississippi Department of Environmental Quality Office of Land and Water Resources P.O. Box 10631 Jackson, MS 39289-0631	Aquifer:
Date drilling completed:8-2-04	(601)961-5210 (601)354-6938 (fax)	
State Law requires that this rep 30 days of completion of drilling Well Owner Information		vith the Department within
		_" Longitude:''
Mailing Address: 209 Cypress	iling Address: 209 Cypress Drive Method of Lat/Long (circle o	
		d GPS, Survey-grade GPS
Leland, MS	¹ ⁄4 ¹ ⁄4 Sec	
$\begin{array}{c} \text{City} & Statematical Statematical$	te Zip Code Distance Direction 7 Miles North	Nearest Town of Leland
	Well Data	······································
Purpose of Well (circle one) Home Ind Date well drilling started:8-2.	Instrial Public Supply Intigation Fish Culture -04 Date well drilling completed:	Other: 8-2-04
	ve Other (describe)	
	pove or below (circle one) land surface Date measured;	
	ceel tape electric tape air line other:	
Hole depth:115 Well de	pth: 115 Well grouted to a depth of	
Type of grout (circle one): Cement	Bentonite Mix	
Casing length: 75 feet Casi 40	ng diameter: <u>10</u> inches Type of casing:	
	en diameter: <u>10</u> inches Type of screen:	
Screen slot size:inches	Setting depth: From76feet to	115 feet
Type of completion (circle all applicable):	Gravel packed Underreamed Telescoped Oper	n hole Natural Development
·	Other (describe):	
Top of lap pipe or reduction in casing:	feet. If telescoped or more than one sc	reen, describe on back of page
Logs run (circle all applicable). No log ru	Blectric Gamma Ray Density Sonic Neutron	Other:
Name of organization running log(s):		· · ·
	ucted, and completed in accordance with all applicable	
Department of Environmental Quality a Irrigation Equipment Patrick M. Chism 069		m Chin
Print Name of Water Well Contractor and	License No. Signature	of Water Well Contractor
		HECEIV


BY: OLWR

If well telescopes please sketch below and show depths.



	Description of Formations Encountered	From	To
	Clav	0	18
	Fine Sand	19	35
	Fine Sand/gravel	36	50
	Med. Sand/gravel	51	115
	· · · ·		
	· · · · · · · · · · · · · · · · · · ·		
· · ·	· · · · · · · · · · · · · · · · · · ·		
			I
		_	
1		_	
		_ <u> </u>	

If more than one screen, show location of each on sketch

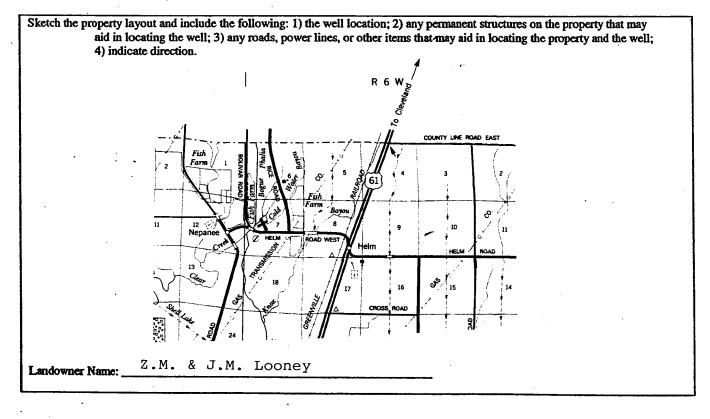

Patrick M Chism

Signature of Water Well Contractor

STATE WELL REPORT				
County: Washington Permit #:	Part 2 's Completion Report nt of Environmental Quality and Water Resources Box 10631 MS 39289-0631)961-5210 54-6938 (fax)			
This report should be prepared by the pump installer in detail and filed with the Department within 30 days of the installation of pump.				
Well Owner Information	Well Location			
Owner Name: Z.M. & J.M. Looney	Latitude: Longitude:			
Mailing Address: 209 Cypress Drive	Method of Lat/Long (circle one): Conventional Survey,			
Leland, MS 38756 City State Zip Code 662-686-9772 Telephone No. ()	USGS quad, Hand-held GPS, Survey-grade GPS <u>SE 14 NW 14 Sec 7 Twn Rng</u> Distance Direction Nearest Town 7 North Leland Milesof			
Pump Type Circle one	Power Type Circle one			
Air Lift Jet ubmersible	Diesel Engine Gasoline Engine Natural Gas			
Bucket Piston Turbine	Etestric Motor Hand Tractor PTO			
Centrifugal Rotary Flowing Well	Windmill Other (specify):			
Other (specify): Horse Power Rating of Motor:15				
Date Pump Installed:	Setting Depth:70feet			
Rated Pump Capacity: 750 Gallons Per Minute	Number of Stages: 1			
Pump Test Data	Method of Measuring Water Level			
Date Well Tested: 8-3-04	Circle one			
Static Water Level (A):Feet Below Land Surface	Air Line Electric Measuring Line Tape			
Pumping Water Level (B):Feet Below Land Surface	Other (specify):			
Drawdown [(B) – (A)]:Feet Below Land Surface	For flowing well, measured shut in head:feet			
Test Pumping Rate:Gallons Per Minute	Well yielded GPM with a drawdown of			
Duration of Pump Test (minimum 4 hours):hours	feet afterhours of pumping			
I HEREBY CERTIFY that the above statements are true to the best of my knowledge. Patrick M. Chism 0695 Patrick M. Chism 0695 Print Name of Pump Installer and License No. (if applicable) Signature of Pump Installer				

AUG 1 3 2004

BY: OLWR