

State Well Report

Part 1

Mississippi Department of Environmental Quality
Office of Land and Water Resources
P.O. Box 10631
Jackson, MS 39289-0631
(601)961-5210
(601)354-6938 (fax)

County: Washington
Permit #: 6004-2007
Irrigation Equipment
Driller: _____
Date drilling completed: 5-13-08

For Office Use Only:
Aquifer: _____
Well #: C-108
L. S. Elevation: _____
E-log #: _____

State Law requires that this report be prepared by the driller in detail and filed with the Department within 30 days of completion of drilling of the well.

Well Owner Information	Well Location
Owner Name: <u>Vernon Skelton</u>	Latitude: <u>33° 28' 82.0"</u> Longitude: <u>90° 48' 48.0"</u>
Mailing Address: <u>5877 Hwy 61 North</u>	Method of Lat/Long (circle one): Conventional Survey, USGS quad, Hand-held GPS, Survey-grade GPS
<u>Leland</u> <u>Ms.</u> <u>38756</u>	<u>SW 1/4 NW 1/4</u> Sec <u>22</u> Twn <u>19N</u> Rng <u>6W</u>
City State Zip Code	Distance <u>5</u> Miles Direction <u>NE</u> of Nearest Town <u>Leland</u>
Telephone No. () _____	

Well Data

Purpose of Well (circle one) Home Industrial Public Supply Irrigation Fish Culture Other: _____

Date well drilling started: 5-13-08 Date well drilling completed: 5-13-08

If flowing, method of flow regulation: Valve _____ Other (describe) _____

Static Water Level: 26 feet above or below (circle one) land surface Date measured: 5-19-08

Method of Measurement (circle one) steel tape electric tape air line other: _____

Hole depth: 127 Well depth: 127 Well grouted to a depth of 10 feet

Type of grout (circle one): Cement Bentonite Mix

Casing length: 87 feet Casing diameter: 12 inches Type of casing: PVC

Screen length: 40 feet Screen diameter: 12 inches Type of screen: PVC

Screen slot size: .050 inches Setting depth: From 88 feet to 127 feet

Type of completion (circle all applicable): Gravel packed Underreamed Telescoped Open hole Natural Development

Other (describe): _____

Top of lap pipe or reduction in casing: _____ feet. If telescoped or more than one screen, describe on back of page

Logs run (circle all applicable) No log run Electric Gamma Ray Density Sonic Neutron Other: _____

Name of organization running log(s): _____

I certify that the well was drilled, constructed, and completed in accordance with all applicable requirements of the Mississippi Department of Environmental Quality and/or the Mississippi Department of Health regulations and state laws.
Irrigation Equipment Inc
Patrick M. Chism 0695

Print Name of Water Well Contractor and License No.

Signature of Water Well Contractor

RECEIVED

MAY 21 2008

BY: OLWR


Vernon Skelton Map

C-108

R 7 W

R 6 W

BOLIVAR COUNTY

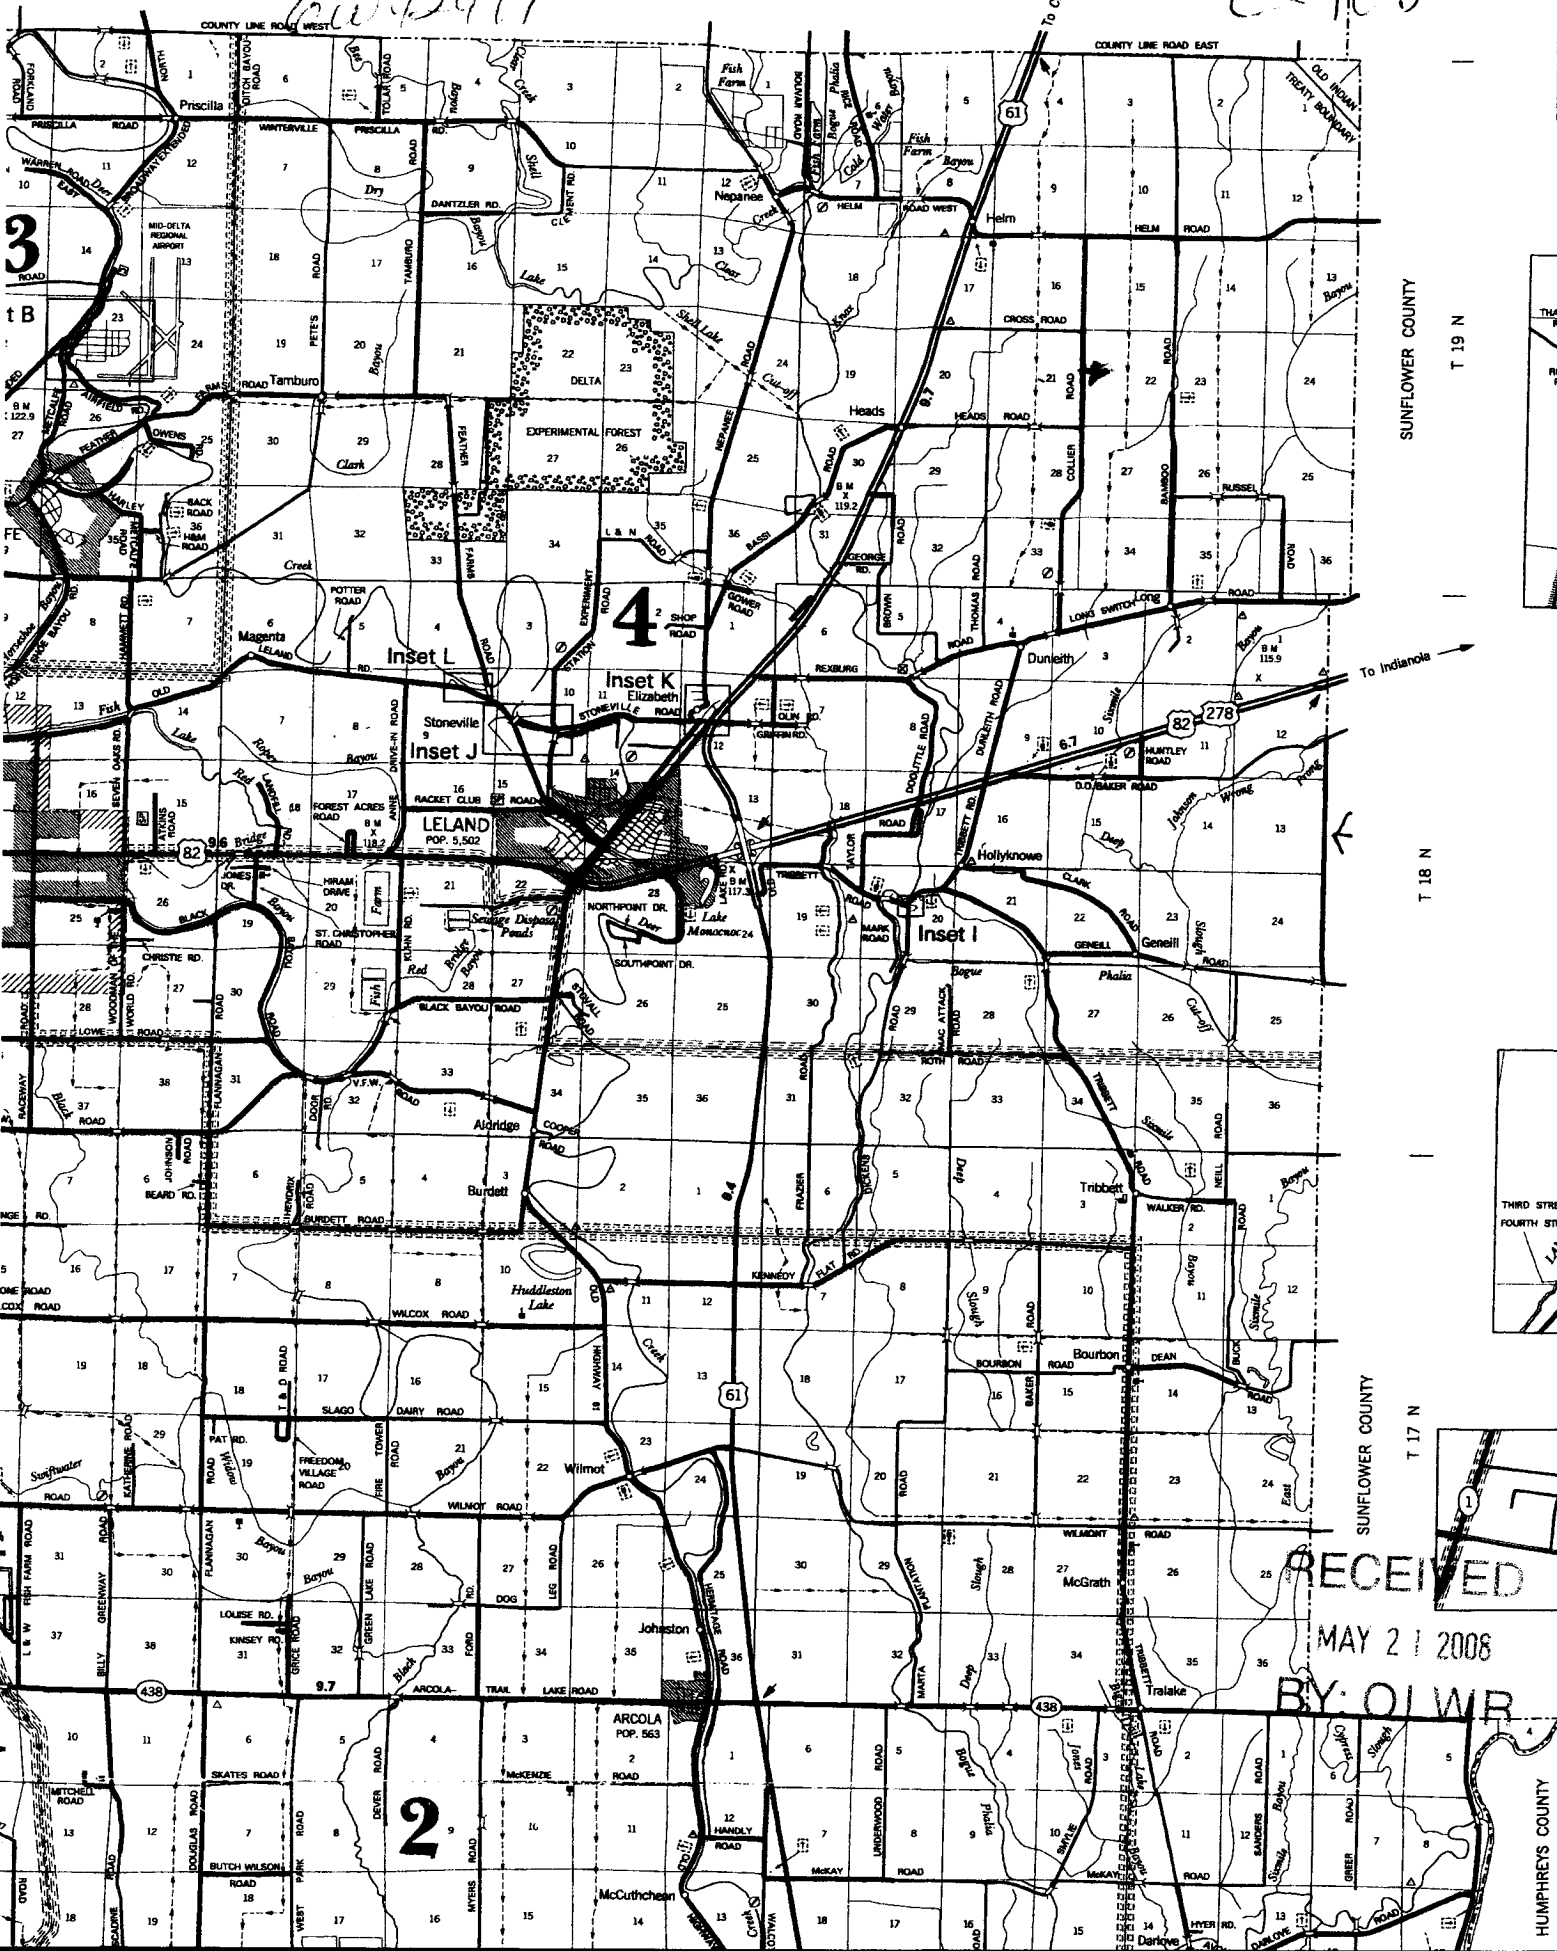

6242499

3

4

2

RECEIVED
 MAY 21 2006
 BY: OJWR

T 19 N

T 18 N

T 17 N

SUNFLOWER COUNTY

SUNFLOWER COUNTY

HUMPHREYS COUNTY

THIRD STREET,
 FOURTH STREET
 LAKE

