

NERREN

# State Well Report

## Part 1

Mississippi Department of Environmental Quality  
Office of Land and Water Resources  
P.O. Box 10631  
Jackson, MS 39289-0631  
(601)961-5210  
(601)354-6938 (fax)

For Office Use Only:

Aquifer: \_\_\_\_\_  
Well #: C119  
L. S. Elevation: \_\_\_\_\_  
E-log #: \_\_\_\_\_

County: WASHINGTON  
Permit #: GW-45112  
Driller: J. NEWCOME 0-773  
Date drilling completed: 6-11-2011

State Law requires that this report be prepared by the driller in detail and filed with the Department within 30 days of completion of drilling of the well.

Well Owner Information	Well Location
Owner Name: <u>Nerren Farms</u>	Latitude: <u>33.29.15</u> " Longitude: <u>90.50.44</u> "
Mailing Address: <u>1254 Devonshire Place</u>	Method of Lat/Long (circle one): <input type="checkbox"/> Conventional Survey, <input checked="" type="checkbox"/> USGS quad, <input checked="" type="checkbox"/> Hand-held GPS, <input checked="" type="checkbox"/> Survey-grade GPS
<u>Greenville MS 38701</u>	<u>SW 1/4 SW 1/4 Sec 17 Twn 19N Rng 06W</u>
City State Zip Code	Distance Direction Nearest Town
Telephone No. ( ) _____	<u>6.5</u> Miles <u>N</u> of <u>LELAND</u>

**Well Data**

Purpose of Well (circle one) Home Industrial Public Supply  Irrigation Fish Culture Other: \_\_\_\_\_

Date well drilling started: 6-11-2011 Date well drilling completed: 6-11-2011

If flowing, method of flow regulation: Valve \_\_\_\_\_ Other (describe) \_\_\_\_\_

Static Water Level: \_\_\_\_\_ feet above or below (circle one) land surface Date measured: \_\_\_\_\_

Method of Measurement (circle one) steel tape electric tape air line other: \_\_\_\_\_

Hole depth: 112 Well depth: 110 Well grouted to a depth of 10 feet

Type of grout (circle one): Cement  Bentonite Mix

Casing length: 70 feet Casing diameter: 16 inches Type of casing: P.V.C.

Screen length: 40 feet Screen diameter: 16 inches Type of screen: P.V.C.

Screen slot size: .050 inches Setting depth: From 70 feet to 110 feet

Type of completion (circle all applicable):  Gravel packed  Underreamed  Telescoped  Open hole  Natural Development

Other (describe): \_\_\_\_\_

Top of lap pipe or reduction in casing: \_\_\_\_\_ feet. If telescoped or more than one screen, describe on back of page

Logs run (circle all applicable):  No log run  Electric  Gamma Ray  Density  Sonic  Neutron Other: \_\_\_\_\_

Name of organization running log(s): \_\_\_\_\_

I certify that the well was drilled, constructed, and completed in accordance with all applicable requirements of the Mississippi Department of Environmental Quality and/or the Mississippi Department of Health regulations and state laws.

JOHN NEWCOME 0-773  
Print Name of Water Well Contractor and License No.


[Signature]  
Signature of Water Well Contractor

RECEIVED  
OCT 13 2011  
BY: OLWR

C119

If well telescopes please sketch below and show depths.

Ground Level

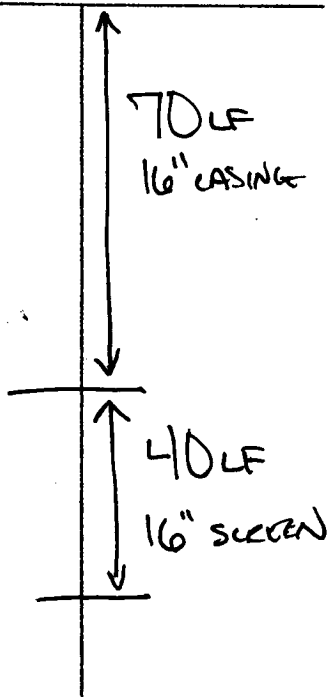

Description of Formations Encountered	From	To
TOP SOIL	0	10
CLAY/SAND STRIPS	10	30
FINE/FAIR SAND	30	50
MED/COURSE SAND	50	70
COARSE SAND/PEBBLES	70	110

If more than one screen, show location of each on sketch

Sketch the property layout and include the following: 1) the well location; 2) any permanent structures on the property that may aid in locating the well; 3) any roads, power lines, or other items that may aid in locating the property and the well; 4) indicate direction.

SEE MAP

Landowner Name: \_\_\_\_\_

John Weaver  
Signature of Water Well Contractor

# STATE WELL REPORT

## Part 2

**Pump Installer's Completion Report**  
 Mississippi Department of Environmental Quality  
 Office of Land and Water Resources  
 P.O. Box 2309  
 Jackson, MS 39225  
 (601)961-5210  
 (601)961-5228 (fax)

County: Washington  
 Permit #: 45712  
 Driller: J. Newcome  
 Date completed: 6/11/11  
Copy information from block on Part 1

**For Office Use Only:**

Aquifer: \_\_\_\_\_  
 Well #: C119  
 Elevation: \_\_\_\_\_

*This part of the report must be completed by a licensed water well contractor or a licensed pump installer. A copy of Part 1 of the report must be attached and both parts filed with the Department at the above address within 30 days of well completion.*

Well Owner Information	Well Location
Owner Name: <u>Nemren Farms</u>	Latitude: <u>33° 29.15"</u> Longitude: <u>90° 50.44"</u>
Mailing Address: <u>1254 Devenshire Place</u>	Method of Lat/Long (check one): Conventional Survey _____
<u>Greenville MS 38701</u> City State Zip Code	USGS quad _____, Hand-held GPS <input checked="" type="checkbox"/> , Survey-grade GPS _____
Telephone No. (____) _____	<u>SW</u> 1/4 <u>SW</u> 1/4 Sec <u>17</u> T <u>19N</u> R <u>06W</u>
	Distance <u>6.5</u> Miles Direction <u>N</u> of Nearest Town <u>Leland</u>

Pump Type	Power Type
Circle one	Circle one
Air Lift <input type="checkbox"/> Jet <input type="checkbox"/> Submersible <input type="checkbox"/>	<input checked="" type="checkbox"/> Diesel Engine <input type="checkbox"/> Gasoline Engine <input type="checkbox"/> Natural Gas
Bucket <input type="checkbox"/> Piston <input type="checkbox"/> <input checked="" type="checkbox"/> Turbine	Electric Motor <input type="checkbox"/> Hand <input type="checkbox"/> Tractor PTO
Centrifugal <input type="checkbox"/> Rotary <input type="checkbox"/> Flowing Well <input type="checkbox"/>	Windmill <input type="checkbox"/> Other (specify): _____
Other (specify): _____	Horse Power Rating of Motor: <u>60</u>
Date Pump Installed: <u>6/20/11</u>	Setting Depth: <u>70</u> feet
Rated Pump Capacity: <u>2500</u> Gallons Per Minute	Number of Stages: <u>1</u>

Pump Test Data	Method of Measuring Water Level
Date Well Tested: _____	Circle one
Static Water Level (A): _____ Feet Below Land Surface	<input type="checkbox"/> Air Line <input type="checkbox"/> Electric Measuring Line <input type="checkbox"/> Steel Tape
Pumping Water Level (B): _____ Feet Below Land Surface	Other (specify): _____
Drawdown [(B) - (A)]: _____ Feet Below Land Surface	For flowing well, measured shut in head: _____ feet
Test Pumping Rate: _____ Gallons Per Minute	Well yielded _____ GPM with a drawdown of _____ feet after _____ hours of pumping
Duration of Pump Test (minimum 4 hours): _____ hours	

This is for (circle one):  New Well  Replacement of Existing Pump  Repair of Existing Pump

I HEREBY CERTIFY that the above statements are true to the best of my knowledge.

Cony Rowe 0-711P C Rowe  
 Print Name of Pump Installer and License No. (if applicable) Signature of Pump Installer

Form: OLWR-SWR-001 (07-09)  
 RECEIVED  
 OCT 13 2011  
 BY: OLWR