

NEELON

### State Well Report

#### Part I - Driller's Log

Mississippi Department of Environmental Quality  
Office of Land and Water Resources  
P.O. Box 2309  
Jackson, MS 39225  
(601)961- 5210  
(601)961- 5228 (fax)

County: WASHINGTON  
 Permit #: GW-45107 ✓  
 Driller: J. NEWCOME 0-773  
 Date drilling completed: 7.5.2012

For Office Use Only:  
 Aquifer: M 227  
 Well #: C130  
 L. S. Elevation: \_\_\_\_\_  
 E-log #: \_\_\_\_\_

**State Law requires that this report be prepared by the license holder responsible for the work and filed with the Department at the above address within 30 days of completion of drilling of the well or borehole.**

Information on Well Owner <i>(Landowner if borehole is not for a water well)</i>	Well or Borehole Location
Owner Name: <u>Nerren Farms</u>	Latitude: <u>33° 29' 50"</u> Longitude: <u>90° 48' 45"</u>
Mailing Address: <u>1254 Devonshire Place</u>	Method of Lat/Long (circle one): <u>50</u> Conventional Survey,
<u>Greenville MS 38701</u>	USGS quad: <u>Hand-held GPS</u> , Survey-grade GPS
City State Zip Code	<u>NW 1/4 SW 1/4 Sec 17 Twn 19N Rng 06W</u>
Telephone No. ( ) _____	Distance <u>6</u> Miles Direction <u>N</u> of Nearest Town <u>LELAND</u>

**Well / Borehole Data**

Date drilling started: 7.5.12 Date drilling completed: 7.5.12 Hole depth: 102 Hole diameter: 24"

Location of the source of any surface water used for drilling: DITCH

Method of dosing and volume of Chlorine used in drilling and development: CHLORINE TABLETS

Logs run (circle all applicable): No log run Electric Gamma Ray Density Sonic Neutron Other: \_\_\_\_\_

Name of organization running log(s): \_\_\_\_\_

Purpose of borehole (check one): Water Well  Geotechnical/Geological Investigation \_\_\_\_\_ Ground Source Heat Pump \_\_\_\_\_

Seismic Survey \_\_\_\_\_ Other (describe) \_\_\_\_\_

***If drilling is not related to water well construction, skip the remainder of this block***

Purpose of Well (check one): Home \_\_\_\_\_ Industrial \_\_\_\_\_ Public Supply \_\_\_\_\_ Irrigation  Fish Culture \_\_\_\_\_ Other: \_\_\_\_\_

If a flowing well, method of flow regulation: Valve \_\_\_\_\_ Other (describe) \_\_\_\_\_

Static Water Level: \_\_\_\_\_ feet above or below (circle one) land surface Date measured: \_\_\_\_\_

Method of Measurement (circle one) steel tape electric tape air line other: \_\_\_\_\_

Well depth: 100 Well grouted to a depth of 10 feet Type of grout (circle one): Neat Cement Bentonite Mix

Casing length: 60 feet Casing diameter: 16 inches Type of casing: P.V.C.

Screen length: 40 feet Screen diameter: 16 inches Type of screen: P.V.C.

Screen slot size: .050 inches Setting depth: From 60 feet to 100 feet

Type of completion (circle all applicable): Gravel packed Underreamed Telescoped Open hole Natural Development

Other (describe): \_\_\_\_\_

Top of lap pipe or reduction in casing: \_\_\_\_\_ feet. ***If telescoped or more than one screen, describe on next page***


Form: OLWR-SWR-1A (04/08)

**RECEIVED**  
 APR 27 2012  
 BY: OLWR

0130

The sketch below only required for water wells

If well telescopes, show depths on sketch.

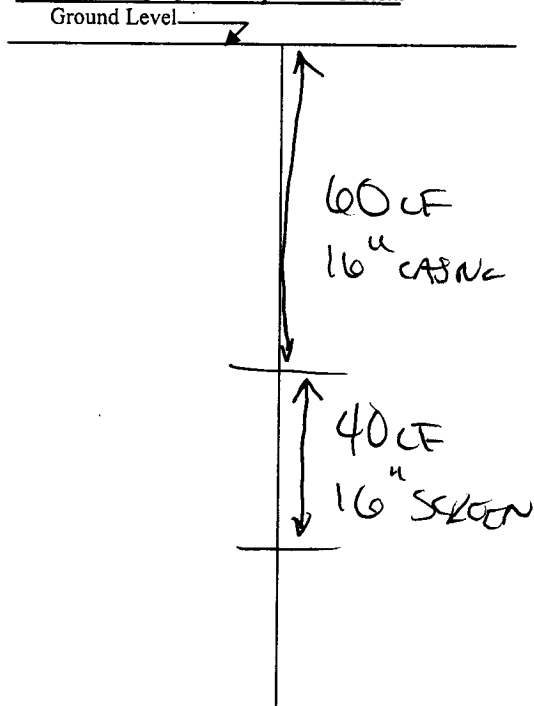

Description of formations encountered must be provided for all wells and boreholes, unless specifically exempted by regulations

Description of Formations Encountered	From (depth)	To (depth)
TOP SOIL	Ground Level	10
CLAY	10	15
SAND	15	55
(COARSE SAND)	55	80
COARSE / PEBBLES	80	100
BOTTOM	100	102

If more than one screen, show location of each on sketch

Sketch the property layout and include the following: 1) the well location; 2) any permanent structures on the property that may aid in locating the well; 3) any roads, power lines, or other items that may aid in locating the property and the well; 4) a north arrow.

SEE MAP

Landowner Name: \_\_\_\_\_

Form: OLWR-SWR-1A (04/08)

I certify that the well/borehole was drilled, constructed, and completed in accordance with all applicable requirements of the Mississippi Department of Environmental Quality and the Mississippi Department of Health regulations, if applicable, and state laws.

JOHN NEWCOME    0.773    7.5.2012    [Signature]  
Print Name of Responsible Licensee and License No.      Date      Signature of Licensee

~~1227~~

# STATE WELL REPORT

## Part 2

**Pump Installer's Completion Report**  
Mississippi Department of Environmental Quality  
Office of Land and Water Resources  
P.O. Box 2309  
Jackson, MS 39225  
(601)961-5210  
(601)961-5228 (fax)

County: WASHINGTON  
 Permit #: GW-45107  
 Driller: S. NEWCOMB 0-773  
 Date completed: 7-5-2012  
*Copy information from block on Part 1*

**For Office Use Only:**  
 Aquifer: \_\_\_\_\_  
 Well #: C130  
 Elevation: \_\_\_\_\_

*This part of the report must be completed by a licensed water well contractor or a licensed pump installer. A copy of Part 1 of the report must be attached and both parts filed with the Department at the above address within 30 days of well completion.*

Well Owner Information	Well Location
Owner Name: <u>NERREN FARMS</u>	Latitude: <u>33° 29' 50"</u> Longitude: <u>90° 48' 45"</u>
Mailing Address: <u>1254 DEVONSHIRE PLACE</u>	Method of Lat/Long (check one): Conventional Survey _____
<u>GREENVILLE MS 38701</u>	USGS quad _____, Hand-held GPS <input checked="" type="checkbox"/> , Survey-grade GPS _____
City State Zip Code	<u>NW</u> ¼ <u>SW</u> ¼ Sec <u>17</u> T <u>19N</u> R <u>06W</u>
Telephone No. (____)	Distance _____ Direction _____ Nearest Town _____
	<u>6</u> Miles <u>N</u> of <u>LELAND</u>

Pump Type	Power Type
Air Lift <input type="checkbox"/> Jet <input type="checkbox"/> Submersible <input type="checkbox"/>	<input checked="" type="checkbox"/> Diesel Engine <input type="checkbox"/> Gasoline Engine <input type="checkbox"/> Natural Gas
Bucket <input type="checkbox"/> Piston <input type="checkbox"/> <input checked="" type="checkbox"/> Turbine <input type="checkbox"/>	Electric Motor <input type="checkbox"/> Hand <input type="checkbox"/> Tractor PTO <input type="checkbox"/>
Centrifugal <input type="checkbox"/> Rotary <input type="checkbox"/> Flowing Well <input type="checkbox"/>	Windmill <input type="checkbox"/> Other (specify): _____
Other (specify): _____	Horse Power Rating of Motor: <u>60</u>
Date Pump Installed: <u>7/10/12</u>	Setting Depth: <u>70</u> feet
Rated Pump Capacity: <u>2400</u> Gallons Per Minute	Number of Stages: <u>1</u>

Pump Test Data	Method of Measuring Water Level
Date Well Tested: _____	<input type="checkbox"/> Air Line <input type="checkbox"/> Electric Measuring Line <input type="checkbox"/> Steel Tape
Static Water Level (A): _____ Feet Below Land Surface	Other (specify): _____
Pumping Water Level (B): _____ Feet Below Land Surface	For flowing well, measured shut in head: _____ feet
Drawdown [(B) - (A)]: _____ Feet Below Land Surface	Well yielded _____ GPM with a drawdown of _____ feet after _____ hours of pumping
Test Pumping Rate: _____ Gallons Per Minute	
Duration of Pump Test (minimum 4 hours): _____ hours	

This is for (circle one):  New Well  Replacement of Existing Pump  Repair of Existing Pump

I HEREBY CERTIFY that the above statements are true to the best of my knowledge.

Comp Rowe 0-711P [Signature]  
 Print Name of Pump Installer and License No. (if applicable) Signature of Pump Installer

Form: OLWR-SWR-10 (07-09) **RECEIVED**  
 AUG 2 2012  
 BY: OLWR