

Washington  
 C 1001  
 12-11-79

MISSISSIPPI  
 BOARD OF WATER COMMISSIONERS  
 416 North State Street  
 Jackson, Mississippi 39201

WATER WELL DRILLERS LOG

12/11 date well completed 19 DB Coogee Drilling firm name Wash. county well located

LANDOWNER: W. T. H. SIMMONS  
 401 CROSS DR  
 LELAND MS  
 (mailing address)

WELL LOCATION:  
 sec. 10 T. 19 N. R. 1 E. S. 10  
 9 miles N of Leland  
 (distance) (direction) (nearest town)

WELL PURPOSE: IRRI  
 (home, irrigation, municipal, industrial)

WELL COMPLETION DATA:  
 (1) diameter (inches) 4 1/2 - 2  
 (2) total depth (feet) 667  
 (3) static water level (feet) 19' below top of ground.  
 (4) casing galv (material), 667 (depth)  
 (size) If telescope see back.  
 (5) screen 10' (length), 657 (depth to top)  
 10 1/2" (size), STEEL (material)  
 (6) pump 1 HP (HP), 19 gpm (yield gpm)  
 Electric (type power)  
 (7) electric log No (yes or no)  
 (organization running log)  
 (8) how well bottom plugged  
 1/2" OF MUD VALUE


description of formations encountered	from to	
CLAY	0	20
SAND	20	80
GRAVEL + SAND	80	115
MUD	115	280
MUD + SAND	280	350
SAND	350	425
FINE SAND + MUD	425	525
MUD	525	620
SAND	620	667

MISSISSIPPI DEPARTMENT OF REVENUE  
 RECEIVED  
 ORDER 12-1979

DRILLERS REMARKS: Sand starts at 140' - good water - could be softer

If well telescopes please  
sketch and show depths.

GROUND LEVEL

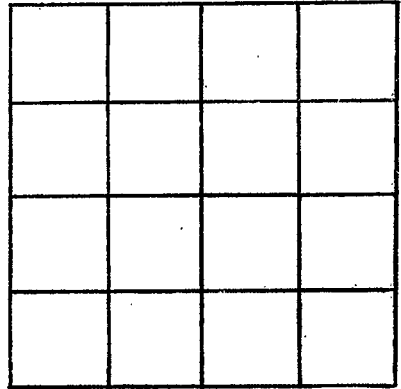

SECTION \_\_\_\_\_

Please indicate well location X.

ADDITIONAL INFORMATION

If more than one screen,  
show locations of each on sketch.