

WASHERBORO

MISSISSIPPI BOARD OF WATER COMMISSIONERS
416 North State Street
Jackson, Mississippi 39201

C 1002
7-27-80

WATER WELL DRILLERS LOG

71231 1980 Cottage Drilling Wash
date well completed firm name county well located

LANDOWNER: Jimmy Etheredge
High Hill N
Leland Ms.
(mailing address)

description of formations encountered	from	to
Mud	0	25
SAND	25	70
SAND + GRAVEL	80	120
MUD	120	340
SAND	350	440

WELL LOCATION:
sec. 23 T 11 N R 6 E
S 5 W
6 miles N of Leland
(distance) (direction) (nearest town)

WELL PURPOSE: HOME
(home, irrigation, municipal, industrial)


- WELL COMPLETION DATA:
- (1) diameter (inches) 4" x 2"
 - (2) total depth (feet) 440
 - (3) static water level (feet) 18 below top of ground.
 - (4) casing PVC 440 (material) (depth)
440 (size) if telescope see back.
 - (5) screen 15' 425 (length) (depth to top)
2" 10 slot PVC (size) (material)
 - (6) pump 1/2 HP 12 gpm (HP) (yield gpm)
Electric (type power)
 - (7) electric log No (yes or no)
 - (organization running log)
 - (8) how well bottom plugged
Lack PRESSURE VALUE

DRILLERS REMARKS:

DEPT. OF NATURAL RESOURCES
BUREAU OF LAND & WATER RESOURCES
JUL 30 1980
RECEIVED

If well telescopes please sketch and show depths.

GROUND LEVEL

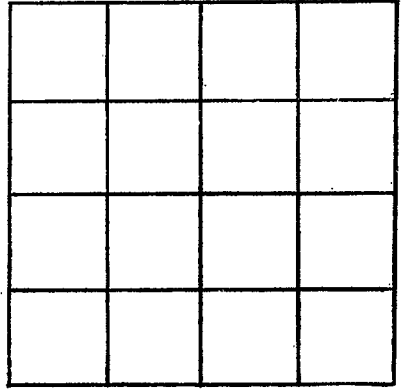

SECTION _____

Please indicate well location X.

ADDITIONAL INFORMATION

If more than one screen,
show locations of each on sketch.