

Washington
C 1004
8-29-80

MISSISSIPPI
 BOARD OF WATER COMMISSIONERS
 416 North State Street
 Jackson, Mississippi 39201

WATER WELL DRILLERS LOG

29 Aug 1980 Lambert Drilling Leak
 date well completed firm name county well located

LANDOWNER:	description of formations encountered	from	to
Mark Walker Leland, Miss. (mailing address)			
WELL LOCATION: sec <u>31</u> T <u>19</u> N R <u>6</u> E S W <u>4</u> miles <u>N</u> of <u>Leland</u> (distance) (direction) (nearest town)	Sand	0	10
WELL PURPOSE: <u>home</u> (home, irrigation, municipal, industrial)	Clay	10	20
WELL COMPLETION DATA: (1) diameter (inches) <u>4 1/2</u> (2) total depth (feet) <u>510</u> (3) static water level (feet) <u>38</u> below above top of ground. (4) casing <u>PVC</u> , <u>490</u> , (material) (depth) <u>4 1/2</u> if telescope see back. (size) (5) screen <u>20</u> , <u>510-490</u> (length) (depth to top) <u>2</u> , <u>PVC</u> (size) (material) (6) pump <u>1</u> , <u>20</u> (HP) (yield gpm) <u>elect</u> (type power) (7) electric log <u> </u> (yes or no) <u> </u> (organization running log) (8) how well bottom plugged <u>back press.</u>	Sand	20	90
	fine gravel	90	180
	Clay	180	320
	Sand & clay	320	410
	Sand fine	410	465
	Sand good	465	510
DRILLERS REMARKS:			

DEPT. OF NATURAL RESOURCES
 BUREAU OF LAND & WATER RESOURCES

DEC 15 1980
 RECEIVED


If well telescopes please sketch and show depths.

GROUND LEVEL

140 4"

190 2"

510 2'50"

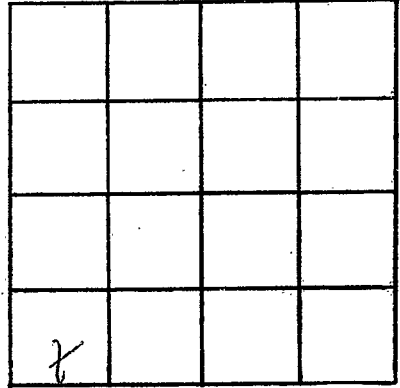

SECTION 4

Please indicate well location X.

ADDITIONAL INFORMATION

If more than one screen, show locations of each on sketch.