

MISSISSIPPI DEPARTMENT OF NATURAL RESOURCES
Bureau of Land and Water Resources
 Southport Mall
 P.O. Box 10631
 Jackson, Mississippi 39209
WATER WELL DRILLERS LOG

Washington
 CL-2271 C
8-21-82

1005

8/21 1982 LAYNE-CENTRAL CO. WASHINGTON
 date well completed firm name county well located

LANDOWNER:	description of formations encountered	from	to
Darrell Livingston	clay	0	9
Rt. 2	coarse sand	9	60
Leland, MS	coarse sand & pea grav.	60	100
(mailing address)	coarse sand and gravel	100	187
WELL LOCATION:	white clay	187	230
sec. <u>19</u> T <u>19</u> N R. <u>6</u> W	clay & hard shale	230	250
<u>5</u> miles NE of Leland	hard shale	250	320
(distance) (direction) (nearest town)	sandy shale	320	360
WELL PURPOSE: <u>home use</u>	clay stks. of hard shale	360	400
(home, irrigation, municipal, industrial)	hard shale	400	448
WELL COMPLETION DATA:	sandy clay	448	469
(1) diameter (inches) <u>6"</u>	soft shale	469	500
(2) total depth (feet) <u>620'</u>	hard shale	500	530
(3) static water level (feet) <u>27'</u> below top of ground.	sand	530	540
(4) casing <u>steel</u> / <u>147'</u> / (material) / (depth)	hard shale & clay	540	571
<u>4"</u> / (size) / If telescope see back.	white sand	571	620
(5) screen <u>30'</u> / <u>590'</u> / (length) / (depth to top)			
<u>2"</u> / (size) / <u>st. steel</u> / (material)			
(6) pump <u>2</u> / <u>25</u> / (HP) / (yield gpm)			
<u>electric</u> / (type power)			
(7) electric log <u>no</u> / (yes or no)			
<u>BP valve</u> / (organization running log)			
(8) how well bottom plugged			

DEPT. OF NATURAL RESOURCES
 BUREAU OF LAND & WATER RESOURCES


SEP - 8 1982

RECEIVED

DRILLERS REMARKS:

If well telescopes please sketch and show depths.

GROUND LEVEL

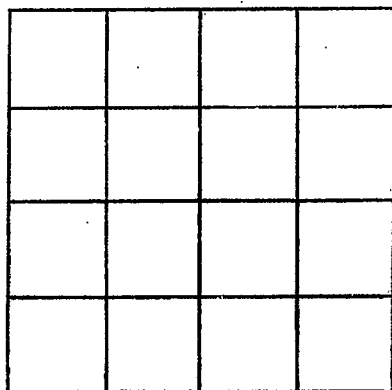

SECTION _____

Please indicate well location X.

ADDITIONAL INFORMATION

If more than one screen, show locations of each on sketch.