

MISSISSIPPI DEPARTMENT OF NATURAL RESOURCES

Bureau of Land and Water Resources

Southport Mall

P.O. Box 10631

Jackson, Mississippi 39209

WATER WELL DRILLERS LOG

WASHINGTON
C2000

6-25-87 Schultz Drilling Washington
date well completed firm name county well located

LANDOWNER: Mrs. VERNON Skeltor

description of formations encountered from to

Rt. 2
Leland, Mo. 38756
(mailing address)

CLAY	0	20
SAND	20	80
SAND + GRAVEL	80	175
ROCK	175	177
SHALE	177	340
CLAY	240	370
SAND	370	420

WELL LOCATION:


sec. 8 T 19 N R 6 E
4 miles N of Leland
(distance) (direction) (nearest town)

WELL PURPOSE:

(home, irrigation, municipal, industrial)

WELL COMPLETION DATA:

- (1) diameter (inches) 2"
- (2) total depth (feet) 420'
- (3) static water level (feet) 34' below top of ground.
- (4) casing PVC, 410' (material), (depth)
- (size) if telescope see back.
- (5) screen 10' 410' (length), (depth to top)
- (size), (material)
- (6) pump 1 10 (HP), (yield gpm)
- elc (type power)
- (7) electric log NO (yes or no)
- X (organization running log)
- (8) how well bottom plugged b/a

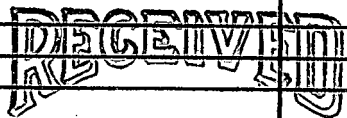


OCT 05 1987

Department of Natural Resources
Bureau of Land & Water Resources

DRILLERS REMARKS:

If well telescopes please sketch and show depths.

GROUND LEVEL

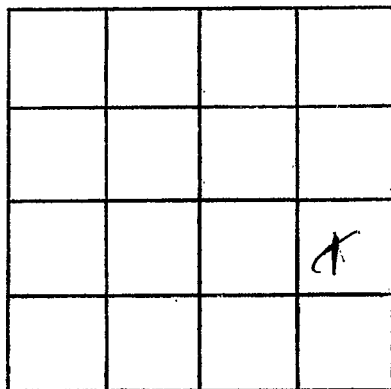

SECTION 8

Please indicate well location X.

ADDITIONAL INFORMATION

If more than one screen, show locations of each on sketch.