

MISSISSIPPI DEPARTMENT OF NATURAL RESOURCES

Bureau of Land and Water Resources

Southport Mall

P.O. Box 10631

Jackson, Mississippi 39209

WATER WELL DRILLERS LOG

Washington
C 2001

9-7-87, 19 Schultz Drilling Washington
date well completed firm name county well located

LANDOWNER: John Pieralisi
Rt. 2, Box 63
Leland ms. 38756
(mailing address)

description of formations encountered	from	to
<u>SANDY topsoil</u>	<u>0</u>	<u>10</u>
<u>SAND</u>	<u>10</u>	<u>50</u>
<u>SAND + GRAVEL</u>	<u>50</u>	<u>90</u>

WELL LOCATION:
sec. 28 T 19 N R 6 E
5 miles NE of Leland
(distance) (direction) (nearest town)

WELL PURPOSE: Home
(home, irrigation, municipal, industrial)

WELL COMPLETION DATA:

- (1) diameter (inches) 2"
- (2) total depth (feet) 90'
- (3) static water level (feet) 24' below top of ground.
- (4) casing PVC 80'
(material) (depth)
- _____ if telescope see back.
(size)
- (5) screen 10' 80'
(length) (depth to top)
- 2" PVC
(size) (material)
- (6) pump 1 10
(HP) (yield gpm)
- ele
(type power)
- (7) electric log No
(yes or no)
- X
(organization running log)
- (8) how well bottom plugged b/w

RECEIVED


OCT 28 1987

Department of Natural Resources
Bureau of Land & Water Resources

DRILLERS REMARKS:

If well telescopes please sketch and show depths.

GROUND LEVEL

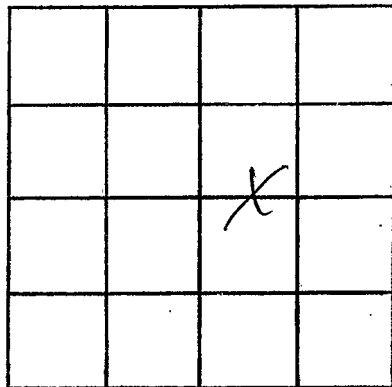

SECTION 28

Please indicate well location X.

ADDITIONAL INFORMATION

If more than one screen,
show locations of each on sketch.