

MISSISSIPPI DEPARTMENT OF ENVIRONMENTAL QUALITY
Bureau of Land and Water Resources

P. O. Box 10631
Jackson, MS 39289-0631
WATER WELL DRILLERS LOG

COUNTY WELL LOCATED <u>Washington</u>	
WELL NUMBER <u>C</u>	CODED
DATE WELL COMPLETED <u>2009</u> <u>7-24-91</u>	

1463

PERMIT NUMBER <u>139404</u>
NAME OF DRILLING FIRM <u>Schultz Drilling</u>

NAME & MAILING ADDRESS OF LANDOWNER <u>Guss Paralisisi + Sons</u> <u>Rt 2</u> <u>Leland MS, 38256</u>		
WELL LOCATION: SEC	TOWNSHIP	RANGE
<u>35</u>	<u>19</u> ^N <u>S</u>	<u>6</u> ^E <u>W</u>
DISTANCE	DIRECTION	NEAREST TOWN
<u>8</u> Miles	<u>East</u>	of <u>Leland</u>
OTHER LANDMARK		
WELL PURPOSE: Home, <u>Irrigation</u> , Municipal, Industrial, Fish Pond, etc.		

PUMP DATA		
PUMP TYPE (Circle One): <u>Submersible</u> , Turbine, Jet, Flowing Well, Other (Describe) _____		
POWER TYPE (Circle One): <u>Electric</u> , Tractor, Diesel, Gasoline, Butane, Other (Describe) _____ H/P <u>20</u>		
Pump Capacity (GPM) <u>1000</u>	No. of Stages <u>1</u>	Setting Depth <u>70</u> FT.
PUMP TEST		
Well yielded _____ GPM with a drawdown of _____ ft. after _____ hours of pumping		


WELL DATA		
Well Depth <u>98</u>	Casing Diameter (In.) <u>10</u>	Casing Length (Ft.) <u>78</u>
Type of Casing <u>pvc</u>	Hole Depth <u>98</u>	Depth to Static Water Level <u>29</u>
TYPE OF COMPLETION: (Circle One or More): <u>Gravel Packed</u> , Underreamed, Telescoped, Natural Development, Open Hole, Other (Describe) <u>Hole plug</u>		
Top of Lap Pipe or Reduction in Casing		
FEET		
IF TELESCOPED OR MORE THAN ONE SCREEN: USE BACK PAGE		

LOG DATA	
TYPE OF LOG RUN (Circle One): <u>No Log Run</u> Electric, Gamma Ray, Density, Sonic, Neutron, Other (Describe) _____	
Name of Organization Running Log	

SCREEN DATA		
Diameter - Inches <u>10</u>	Length - Feet <u>20</u>	Slot Size - Inches <u>.032</u>
Screen Type <u>pvc</u>	Depth to Bottom - Feet <u>98</u>	

GEOLOGIC DATA (Office Use Only)			
Surface Elev.	Geologic Unit	Unit Thickness	Depth to Top
Subs. SWL	Date	Analysis	Aquifer Test
Driller's Remarks			

DESCRIPTION OF FORMATIONS ENCOUNTERED	FROM	TO
<u>Top soil</u>	<u>0</u>	<u>16</u>
<u>fine sand</u>	<u>16</u>	<u>35</u>
<u>med sand</u>	<u>35</u>	<u>60</u>
<u>Good Sand p-gravel</u>	<u>60</u>	<u>98</u>

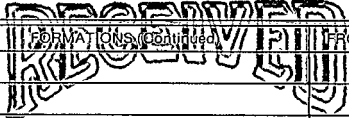

DEC 06 1991

Dept. of Environmental Quality
Bureau of Land & Water Resources

IF MORE SPACE IS NEEDED, USE BACK

If well telescopes please sketch and show depths.

GROUND LEVEL

	X		

SECTION 35

Please indicate well location X.

ADDITIONAL INFORMATION

If more than one screen,
show location of each on sketch.