

MISSISSIPPI DEPARTMENT OF ENVIRONMENTAL QUALITY
Bureau of Land and Water Resources

P. O. Box 10631
Jackson, MS 39289-0631
WATER WELL DRILLERS LOG

COUNTY WELL LOCATED <u>Washington</u>	
WELL NUMBER <u>C</u>	CODED
DATE WELL COMPLETED <u>2010</u> <u>4-18-91</u>	

PERMIT NUMBER
NAME OF DRILLING FIRM <u>Schultz Drilling</u>

NAME & MAILING ADDRESS OF LANDOWNER <u>Hewber Farms</u>		
<u>514 Arnold Av.</u>		
<u>Greenville Ms. 38701</u>		
WELL LOCATION:	SEC	TOWNSHIP RANGE
	<u>22</u>	<u>19</u> ^N / _S <u>6</u> ^E / _W
DISTANCE	DIRECTION	NEAREST TOWN
<u>5</u> Miles	<u>NE</u>	of <u>Lehnd</u>
OTHER LANDMARK		
WELL PURPOSE <input checked="" type="checkbox"/> Home Irrigation, Municipal, Industrial, Fish Pond, etc.		

PUMP DATA		
PUMP TYPE (Circle One): Submersible, Turbine, <input checked="" type="checkbox"/> Jet, Flowing Well, Other (Describe) _____		
POWER TYPE (Circle One): <input checked="" type="checkbox"/> Electric, Tractor, Diesel, Gasoline, Butane, Other (Describe) _____ H/P <u>21</u>		
Pump Capacity (GPM) <u>10</u>	No. of Stages <u>1</u>	Setting Depth <u>60</u> FT.
PUMP TEST		
Well yielded _____ GPM with a drawdown of _____ ft. after _____ hours of pumping		

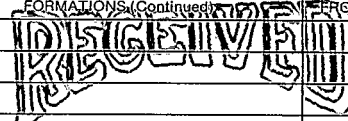
WELL DATA		
Well Depth <u>80ft</u>	Casing Diameter (In.) <u>2</u>	Casing Length (Ft.) <u>70</u>
Type of Casing <u>pvc</u>	Hole Depth <u>80ft</u>	Depth to Static Water Level <u>30 ft</u>
TYPE OF COMPLETION: (Circle One or More): <input checked="" type="checkbox"/> Gravel Packed, Underreamed, Telescoped, Natural Development, Open Hole, Other (Describe) <u>Hole plug</u>		
Top of Lap Pipe or Reduction in Casing		
FEET		
IF TELESCOPED OR MORE THAN ONE SCREEN: USE BACK PAGE		

LOG DATA	
TYPE OF LOG RUN (Circle One): Electric, Gamma Ray, Density, Sonic, Neutron, Other (Describe) _____ <input checked="" type="checkbox"/> No Log Run	
Name of Organization Running Log	

SCREEN DATA		
Diameter - Inches <u>2</u>	Length - Feet <u>10</u>	Slot Size - Inches <u>.010</u>
Screen Type <u>pvc</u>	Depth to Bottom - Feet <u>80ft</u>	

GEOLOGIC DATA (Office Use Only)			
Surface Elev.	Geologic Unit	Unit Thickness	Depth to Top
Subs. SWL	Date	Analysis	Aquifer Test
Driller's Remarks			

DESCRIPTION OF FORMATIONS ENCOUNTERED	FROM	TO
<u>clay</u>	<u>0</u>	<u>20</u>
<u>sand</u>	<u>20</u>	<u>50</u>
<u>med to coarse sand</u>	<u>50</u>	<u>80</u>
<u>some p-g</u>		

FORMATIONS (Continued)		FROM	TO
			
DEC 06 1991			
Dept. of Environmental Quality Bureau of Land & Water Resources			
IF MORE SPACE IS NEEDED, USE BACK			

If well telescopes please
sketch and show depths.

GROUND LEVEL

		X	

SECTION 22

Please indicate well location X.

ADDITIONAL INFORMATION

If more than one screen,
show location of each on sketch.