

MISSISSIPPI DEPARTMENT OF ENVIRONMENTAL QUALITY

Office of Land and Water Resources

P. O. Box 10631
Jackson, MS 39289-0631

WATER WELL DRILLERS LOG

COUNTY WELL LOCATED Washington	
WELL NUMBER C	CODED
DATE WELL COMPLETED 10-11-95	

PERMIT NUMBER
NAME OF DRILLING FIRM Irrigation Equipment
Indianola, MS 38751

NAME & MAILING ADDRESS OF LANDOWNER Looney Farms		
128 Lilac Drive		
Leland, MS 38756		
WELL LOCATION: SEC	TOWNSHIP	RANGE
6	19N N S	6W E W
DISTANCE 7 Miles	DIRECTION North	NEAREST TOWN Leland of
OTHER LANDMARK		
WELL PURPOSE: Home, Irrigation, Municipal, Industrial, Fish Pond, etc. Irrigation		

PUMP DATA		
PUMP TYPE (Circle One): Submersible, Turbine , Jet, Flowing Well, Other (Describe)		
POWER TYPE (Circle One): Electric, Tractor, Diesel , Gasoline, Butane, Other (Describe) H/P 60		
Pump Capacity (GPM) 3000	No. of Stages 1	Setting Depth 60 FT.
PUMP TEST		
Well yielded _____ GPM with a drawdown of _____ ft. after _____ hours of pumping		

WELL DATA		
Well Depth 115	Casing Diameter (In.) 16	Casing Length (Ft.) 75
Type of Casing PVC	Hole Depth 115	Depth to Static Water Level 21 ft.

LOG DATA	
TYPE OF LOG RUN (Circle One): No Log Run, Electric, Gamma Ray, Density, Sonic, Neutron, Other (Describe)	
Name of Organization Running Log	

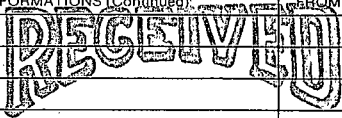
TYPE OF COMPLETION: (Circle One or More):
Gravel Packed, Underreamed, Telescoped,
Natural Development, Open Hole, Other
(Describe)

GEOLOGIC DATA (Office Use Only)			
Surface Elev.	Geologic Unit	Unit Thickness	Depth to Top
Subs. SWL	Date	Analysis	Aquifer Test

WELL GROUTED TO A DEPTH OF _____ FEET
Type Grout (circle one): Cement, Bentonite, or Mix

SCREEN DATA		
Diameter - Inches 16	Length - Feet 40	Slot Size - Inches .032
Screen Type PVC	Depth to Bottom - Feet 115	

Driller's Remarks	
Top of Lap Pipe or Reduction in Casing FEET IF TELESKOPED OR MORE THAN ONE SCREEN: USE BACK PAGE	

DESCRIPTION OF FORMATIONS ENCOUNTERED	FROM	TO	FORMATIONS (Continued)	FROM	TO
Clay	0	15	 NOV 08 1995 Dept. of Environmental Quality Office of Land & Water Resources		
Fine Sand	15	55			
Fine Sand & Gravel	55	75			
Med. Sand & Gravel	75	115			

IF MORE SPACE IS NEEDED, USE BACK

If well telescopes please sketch and show depths.

GROUND LEVEL

		X	

SECTION 6

Please indicate well location X.

ADDITIONAL INFORMATION

If more than one screen,
show location of each on sketch.