

MISSISSIPPI DEPARTMENT OF ENVIRONMENTAL QUALITY

Office of Land and Water Resources

P. O. Box 10631
Jackson, MS 39289-0631
WATER WELL DRILLERS LOG

COUNTY WELL LOCATED Washington	
WELL NUMBER C-2026	CODED
DATE WELL COMPLETED 7-13-96	

PERMIT NUMBER
NAME OF DRILLING FIRM Irrigation Equipment
Indianola, MS 38751

NAME & MAILING ADDRESS OF LANDOWNER			
Triple C Farm / Zepponi			
Rt. 2, Box L20			
Leland, MS 38756			
WELL LOCATION:	SEC	TOWNSHIP	RANGE
	10	19N	N 6W E S W
DISTANCE	DIRECTION	NEAREST TOWN	
5	East	Leland	
OTHER LANDMARK			
WELL PURPOSE: Home, Irrigation, Municipal, Industrial, Fish Pond, etc. Irrigation			

PUMP DATA			
PUMP TYPE (Circle One): Submersible Turbine, Jet, Flowing Well, Other (Describe) _____			
POWER TYPE (Circle One): Electric Tractor, Diesel, Gasoline, Butane, Other (Describe) _____ H/P 25			
Pump Capacity (GPM)	No. of Stages	Setting Depth	
1200	1	60 FT.	
PUMP TEST			
Well yielded _____ GPM with a drawdown of _____ ft. after _____ hours of pumping			

WELL DATA		
Well Depth	Casing Diameter (In.)	Casing Length (Ft.)
117	10	77
Type of Casing	Hole Depth	Depth to Static Water Level
PVC	117	23 ft.
TYPE OF COMPLETION: (Circle One or More): Gravel Packed Underreamed, Telescoped, Natural Development, Open Hole, Other (Describe) _____		

LOG DATA	
TYPE OF LOG RUN (Circle One): Electric, Gamma Ray, Density, Sonic, Neutron, Other (Describe) _____ No Log Run	
Name of Organization Running Log	

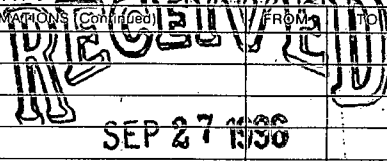
WELL GROUTED TO A DEPTH OF _____ FEET
Type Grout (circle one): Cement, Bentonite, or Mix

GEOLOGIC DATA (Office Use Only)			
Surface Elev.	Geologic Unit	Unit Thickness	Depth to Top
Subs. SWL	Date	Analysis	Aquifer Test

SCREEN DATA		
Diameter - Inches	Length - Feet	Slot Size - Inches
10	40	.050
Screen Type	Depth to Bottom - Feet	
PVC	117	

Driller's Remarks
Top of Lap Pipe or Reduction in Casing
FEET
IF TELESCOPED OR MORE THAN ONE SCREEN: USE BACK PAGE

DESCRIPTION OF FORMATIONS ENCOUNTERED	FROM	TO
Clay	0	20
Fine Sand	20	35
Fine Sand & Gravel	35	60
Med. sand & Gravel	60	117

FORMATIONS (Continued)	FROM	TO
		
Dept. of Environmental Quality Office of Land & Water Resources		
IF MORE SPACE IS NEEDED, USE BACK		

If well telescopes please
sketch and show depths.

GROUND LEVEL

		X	

SECTION: 10

Please indicate well location X.

ADDITIONAL INFORMATION

If more than one screen,
show location of each on sketch.