

MISSISSIPPI DEPARTMENT OF ENVIRONMENTAL QUALITY

Office of Land and Water Resources

P. O. Box 10631
Jackson, MS 39289-0631
WATER WELL DRILLERS LOG

COUNTY WELL LOCATED:
Washington

WELL NUMBER: **C 2030**

DATE WELL COMPLETED:
3-19-98

PERMIT NUMBER: _____

NAME OF DRILLING FIRM:
IRRIGATION EQUIPMENT.

PHONE NUMBER:
601/887-2555

NAME & MAILING ADDRESS OF LANDOWNER:
INDIANOLA, MS

American A9 SERVICES

525 FAIRVIEW AVE.

Greenville, MS 38701

WELL LOCATION: SEC _____ TOWNSHIP _____ RANGE _____

14 19 N 6 E W

DISTANCE _____ MILES _____ OF _____

DIRECTION _____ NEAREST TOWN _____

OTHER LANDMARK _____

WELL PURPOSE: Home, Irrigation, Municipal, Industrial, Fish Pond, etc.
Fill water Trailers

PUMP DATA

PUMP TYPE (Circle One):
Submersible, Turbine, Jet, Flowing Well,
Other (Describe) _____

POWER TYPE (Circle One):
Electric, Tractor, Diesel, Gasoline, Butane,
Other (Describe) _____ H/P **3**

Pump Capacity (GPM) _____ No. of Stages _____ Setting Depth **60** FT.

PUMP TEST

Well yielded _____ GPM with
a drawdown of _____ ft.
after _____ hours of pumping

WELL DATA

Well Depth 104	Casing Diameter (In.) 4	Casing Length (Ft.) 84
Type of Casing PVC	Hole Depth 104	Depth to Static Water Level 24ft.

TYPE OF COMPLETION: (Circle One or More):
Gravel Packed, Underreamed, Telescoped,
Natural Development, Open Hole, Other _____

WELL GROUTED TO A DEPTH OF _____ FEET
Type Grout (circle one): Cement, Bentonite, or Mix

LOG DATA

TYPE OF LOG RUN (Circle One):
No Log Run, Electric, Gamma Ray, Density, Sonic, Neutron,
Other (Describe) _____

Name of Organization Running Log _____

SCREEN DATA

Diameter - Inches 4	Length - Feet 20	Slot Size - Inches .010
Screen Type PVC		Depth to Bottom - Feet 104

GEOLOGIC DATA (Office Use Only)

Surface Elev.	Geologic Unit	Unit Thickness	Depth to Top
Subs. SWL	Date	Analysis	Aquifer Test

Driller's Remarks _____

Top of Lap Pipe or Reduction in Casing _____ FEET

IF TELESCOPED OR MORE THAN ONE SCREEN: USE BACK PAGE


DESCRIPTION OF FORMATIONS ENCOUNTERED	FROM	TO	FORMATIONS (Continued)	
			FROM	TO
CLAY	0	18		
FINE SAND	18	35		
FINE SAND & GRAVEL	35	45		
MED. SAND & GRAVEL	45	104		

05-04-98A10:01 RCVD

IF MORE SPACE IS NEEDED, USE BACK

If well telescopes please sketch and show depths.

GROUND LEVEL

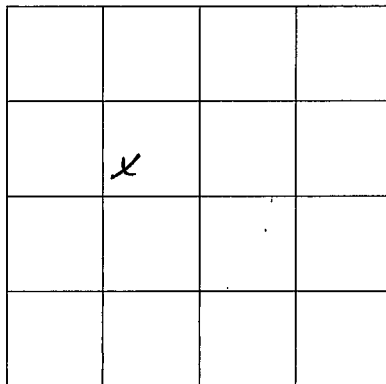

SECTION 14

Please indicate well location X.

ADDITIONAL INFORMATION

If more than one screen,
show location of each on sketch.