

**MISSISSIPPI DEPARTMENT OF ENVIRONMENTAL QUALITY**

Office of Land and Water Resources

COUNTY WELL LOCATED <b>Washington</b>	
WELL NUMBER <b>C 2036</b>	CODED
DATE WELL COMPLETED <b>5-28-99</b>	

PERMIT NUMBER
NAME OF DRILLING FIRM <b>Irrigation Equipment Inc.</b>
<b>Indianola, MS</b>

P. O. Box 10631  
Jackson, MS 39289-0631  
**WATER WELL DRILLERS LOG**

NAME & MAILING ADDRESS OF LANDOWNER <b>Nerren Farms</b>			
<b>450 Williams Bayou Rd.</b>			
<b>Greenville, MS 38701</b>			
WELL LOCATION:	SEC	TOWNSHIP	RANGE
<b>SE/NE</b>	<b>17</b>	<b>19N</b>	<b>6W</b>
		<b>S</b>	<b>E</b>
			<b>W</b>
DISTANCE	DIRECTION	NEAREST TOWN	
<b>6</b>	<b>NE</b>	<b>Leland</b>	
Miles	of		
OTHER LANDMARK			
WELL PURPOSE: Home, Irrigation, Municipal, Industrial, Fish Pond, etc. <b>Irrigation Pivot</b>			

<b>PUMP DATA</b>		
PUMP TYPE (Circle One): Submersible, <b>turbine</b> Jet Flowing Well, Other (Describe) _____		
POWER TYPE (Circle One): Electric, Tractor, <b>Diesel</b> Gasoline, Butane, Other (Describe) _____ H/P <b>80</b>		
Pump Capacity (GPM) <b>1500</b>	No. of Stages <b>3</b>	Setting Depth <b>50 FT.</b>
PUMP TEST		
Well yielded _____ GPM with a drawdown of _____ ft. after _____ hours of pumping		

<b>WELL DATA</b>		
Well Depth <b>117</b>	Casing Diameter (In.) <b>12</b>	Casing Length (Ft.) <b>77</b>
Type of Casing <b>PVC</b>	Hole Depth <b>117</b>	Depth to Static Water Level <b>21ft</b>
TYPE OF COMPLETION: (Circle One or More): <b>Gravel Packed</b> , Underreamed, Telescoped, Natural Development, Open Hole, Other		
WELL GROUTED TO A DEPTH OF _____ FEET Type Grout (circle one): Cement, Bentonite, or Mix		

<b>LOG DATA</b>	
TYPE OF LOG RUN (Circle One): Electric, Gamma Ray, Density, Sonic, Neutron, Other (Describe) _____ No Log Run,	
Name of Organization Running Log	

<b>SCREEN DATA</b>		
Diameter - Inches <b>12</b>	Length - Feet <b>40</b>	Slot Size - Inches <b>.050</b>
Screen Type <b>PVC</b>	Depth to Bottom - Feet <b>117</b>	


<b>GEOLOGIC DATA (Office Use Only)</b>			
Surface Elev.	Geologic Unit	Unit Thickness	Depth to Top
Subs. SWL	Date	Analysis	Aquifer Test
Driller's Remarks <b>Big-D</b>			
Top of Lap Pipe or Reduction in Casing <b>FEET</b> IF TELESKOPED OR MORE THAN ONE SCREEN: USE BACK PAGE			

DESCRIPTION OF FORMATIONS ENCOUNTERED	FROM	TO
Clay	0	18
Fine Sand	18	55
Fine Sand & Gravel	55	70
Med. Sand & Gravel	70	117

FORMATIONS (Continued)	FROM	TO
<b>RECEIVED</b>		
<b>SEP 21 1999</b>		
Dept. of Environmental Quality Office of Land & Water Resources		
IF MORE SPACE IS NEEDED, USE BACK		

If well telescopes please sketch and show depths.

GROUND LEVEL

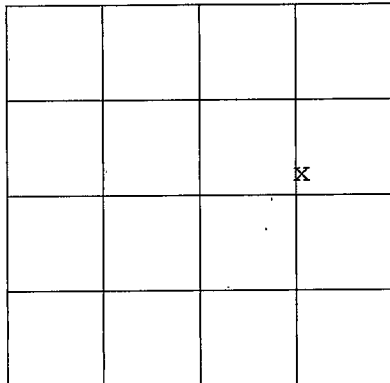

SECTION 17

Please indicate well location X.

**ADDITIONAL INFORMATION**

---

---

If more than one screen,  
show location of each on sketch.