

6 D 7  
10-19-62

WATER WELL DRILLERS LOG

Date: 10/19, 1962, Driller: Bailey Drly Co. County: Washington  
(Name)

- (1) Owner of Land: Bill Harbison  
(Name)  
Greenville, Miss  
Hwy 82 W (Address)
- (2) Location: 1/4, 1/4, Sec. 11 T18 R9,  
3 miles SW of Greenville  
(distance) (direction) (Nearest Town)
- (3) Topography: Flat  
(Hilly) (Flat) (Level) ^
- (4) Purpose of Well: Domestic  
(Domestic Irrigation  
Municipal, Industrial, Other)

Description & Color of Materials Sand, Clay, Red Clay, Shell, etc.	Thick- ness Feet	Depth Feet
<u>Sand</u>		<u>97</u>
<u>Gravel</u>		<u>105</u>
<u>Mud</u>		<u>400</u>
<u>Sand &amp; Mud</u>		<u>446</u>
<u>Sand</u>		<u>505</u>


Information upon completion of well:

- (1) Diameter: 4 X 2 1/2 inches.
- (2) Total Depth: 505 feet.
- (3) Water Level: 39 feet below top of ground.
- (4) Cased to: all way, Size 4 X 2 1/2.
- (5) Screen: Size 2 1/2, Length 20 ft.
- (6) Were any formations sealed against pollution?  
\_\_\_\_\_ yes,  no.

If YES, depth of formation \_\_\_\_\_

Why \_\_\_\_\_

Drillers Remarks: \_\_\_\_\_

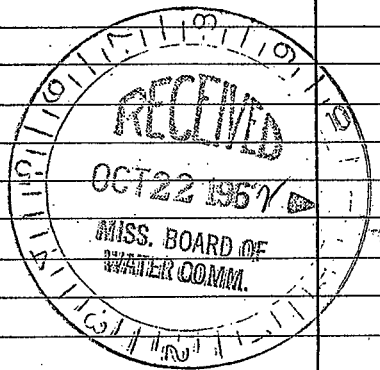

(Use Back Side)

Well No.

[The page contains extremely faint and illegible text, likely bleed-through from the reverse side of the document. The text is scattered across the page and does not form any recognizable words or sentences.]