

WASH 'N

D39

11-60

CODED CODED

WATER WELL DRILLERS LOG

OK gus
Washington

Date: Nov, 19 60, Driller: David F. Berry & Son County

(Name)

(1) ^{CODED} Owner of Land: Fulton
(Name)
Greenville, Miss
(Address)

(2) Location: 1/4, 1/4, Sec 10 18N9W
T R
5 miles SW of Greenville
(distance) (direction) (Nearest Town)

(3) Topography: _____
(Hilly) (Flat) (Level)

(4) Purpose of Well: _____
(Domestic Irrigation
Municipal, Industrial, Other)

Information upon completion of well:

(1) Diameter _____ inches.

(2) Total Depth 436 feet.

(3) Water Level 54' feet below top of ground.

(4) Cased to _____, Size _____

(5) Screen: Size .007 & .006 Length 30'

(6) Were any formations sealed against pollution?
_____ yes, _____ no.


If YES depth of formation _____

Why _____

Drillers Remarks: _____

Description & Color of Materials Sand, Clay, Red Clay, Shell, etc.	Thick- ness Feet	Depth Feet
clay	20	
clay & sand	20	40
sand	20	60
gravel	20	80
gravel 4" shale bottom 96'	20	100
Shale	20	120
Shale hard	20	140
Moody 10' sand	20	160
shale	20	180
shale	20	200
rock	20	220
shale	20	240
shale	20	260
shale	20	280
shale sandy	20	300
sand fine	20	320
sand	20	340
sand	20	360
sand bottom 385'	20	380
sand 5' shale	20	400
sand	20	420
sand	16	436

Ineff. info to locate

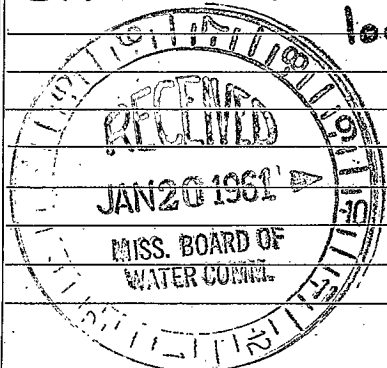

(Use Back Side)

Well No.

1912

1913

1914

1926