

WASHINGTON
D41 1041
7-21-72

MISSISSIPPI
 BOARD OF WATER COMMISSIONERS
 416 North State Street
 Jackson, Mississippi 39201

WATER WELL DRILLERS LOG

CODED

7-21 date well completed 1972 OWENS PLUMBING & firm name 1041 county well located

LANDOWNER: QUEEN CITY
FURNITURE CO.
Greenville, MISS
 (mailing address)

description of formations encountered	from	to
<u>4 1/2' top soil</u>	<u>0</u>	<u>30</u>
<u>1' clay</u>	<u>30</u>	<u>147</u>
<u>sandy + gravel</u>	<u>147</u>	<u>294</u>
<u>sand</u>	<u>294</u>	<u>530</u>

WELL LOCATION:
15-24 sec. 18 T. 18 N. S. R. 8 E. W. of Greenville
 (distance) (direction) (nearest town)

WELL PURPOSE: Commercial
 (home, irrigation, municipal, industrial)

- WELL COMPLETION DATA:
- (1) diameter (inches) 4" x 2"
 - (2) total depth (feet) 530'
 - (3) static water level (feet) 30 below above top of ground.
 - (4) casing Galv. (material) 500 (depth)
 - (size) If telescope see back.
 - (5) screen 30' (length) 530' (depth to top)
 - 2" (size) SS (material)
 - (6) pump 1 1/2 (HP) 60 (yield gpm)
 - Elec. (type power)
 - (7) electric log no (yes or no)

CODED

(organization running log)

JUL 21 1972


(8) how well bottom plugged S-B

MISS. BD. OF
 WATER COMM.

DRILLERS REMARKS: OWENS

If well telescopes please sketch and show depths.

GROUND LEVEL

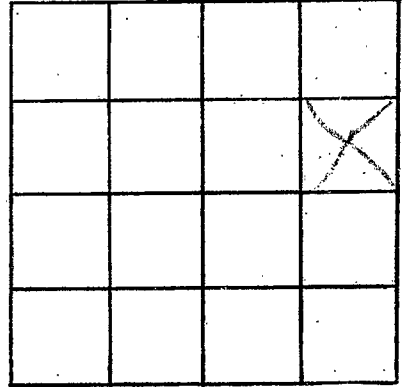

SECTION _____

Please indicate well location X.

ADDITIONAL INFORMATION

If more than one screen, show locations of each on sketch.