

WASH. MISSISSIPPI BOARD OF WATER COMMISSIONERS

DCZ
10-28-65

WATER WELL DRILLERS LOG

CODED

11/2/65
C600

Date: Oct. 28, 19 65, Driller: Layne-Central Company County Washington

(Name)

- (1) Owner of Land: Farmers, Inc.
(Name)
Greenville, Mississippi
(Address)
- (2) Location: SW 1/4, SW 1/4, Sec. 13 T18R8 W
1 miles east of Greenville
(distance) (direction) (Nearest Town)
- (3) Topography: flat
(Hilly) (Flat) (Level)
- (4) Purpose of Well: domestic
(Domestic Irrigation
Municipal, Industrial, Other)

Description & Color of Materials Sand, Clay, Red Clay, Shell, etc.	Thick- ness Feet	Depth Feet
Clay	29	29
Fine sand	30	69
Coarse sand	22	91
Coarse sand & pea gravel	37	128
Clay & shale	50	178
Fine sand	22	200
Clay, strks. shale	120	320
Sandy shale	50	370
Sand rock	2	372
Shale	10	382
Sand rock	1	383
Shale & clay	17	400
Sand, strks. shale	16	416
Sand	44	460
Sand & shale	16	476

Information upon completion of well:

- (1) Diameter 8x4 inches.
- (2) Total Depth 476 feet.
- (3) Water Level 43' 8" feet below top of ground.
272' 10" ^{4 2 5} ^{4 1 4} 4"
- (4) Cased to 152', Size 8"
11' lap
- (5) Screen: Size 4", Length 42'
21' of 4" blank
- (6) Were any formations sealed against pollution?

yes yes, no no.


If YES depth of formation Lead seal,
Packer above screen, cement plug and
Why shot at bottom.

Drillers Remarks:

75 GPM .

Electric power.

CODED

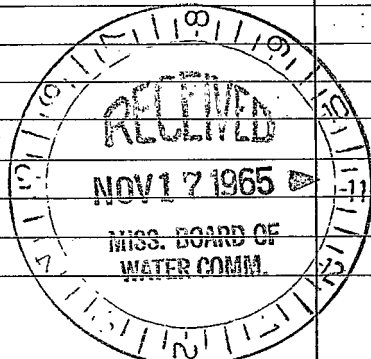

(Use Back Side)

Well No.

1870

1871

1872

1873

1874

1875

1876