

D67  
6-16-59

WATER WELL DRILLERS LOG

**CODED**

1/9/66  
701

Date: June 16, 1959, Driller: Layne-Central Company County Washington

(Name)

(1) Owner of Land: The Itzig Company

800 Alexander St. (Name)  
Greenville, Mississippi

(Address)

(2) Location: SE 1/4, NW 1/4, Sec. 4 T18R8

           miles            of Greenville  
(distance) (direction) (Nearest Town)

(3) Topography: flat

(Hilly) (Flat) (Level)

(4) Purpose of Well: domestic

(Domestic Irrigation  
Municipal, Industrial, Other)

Description & Color of Materials Sand, Clay, Red Clay, Shell, etc.	Thick- ness Feet	Depth Feet
Clay	28	28
Coarse sand	85	113
Blue clay	7	120
Hard shale	20	140
Clay	20	160
Sandy shale	40	200
Fine sand	47	247
Rock	2	249
Sandy shale	14	263
Fine sand	17	280
Sand & shale	13	293
Shale	127	420
Shale & sandy shale	51	471
Sand (Bottom)	56	527

Information upon completion of well:

(1) Diameter 8x4 inches.

(2) Total Depth 527 feet.

(3) Water Level 90 feet below top of ground.

(4) Cased to 189' Size 4"  
10' lap

(5) Screen: Size 4", Length 40'  
10' of 4" blank

(6) Were any formations sealed against pollution?

yes yes,            no.

If YES depth of formation Concrete plug,  
mechanical seal, packer above the  
screen and shot at bottom.


Why           

Drillers Remarks:           

100 GPM.

Electric power.

**CODED**

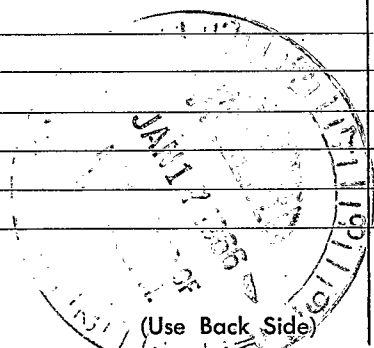

Well No.

