

WASH.
D 70
11-8-60

MISSISSIPPI BOARD OF WATER COMMISSIONERS


WATER WELL DRILLERS LOG

WASHINGTON

Date: 11-8-1960, Driller: Layne-Central Co. County

(Name)

	Description & Color of Materials Sand, Clay, Red Clay, Shell, etc.	Thick- ness Feet	Depth Feet
(1) Owner of Land: <u>Atkins Saw Company</u> (Name) <u>Greenville, Miss.</u> (Address)	clay	20	20
(2) Location: $\frac{1}{4}$, $\frac{1}{4}$, Sec. <u>11 T18^N R8^W</u> <u>1 1/2</u> miles <u>in Greenville</u> (distance) (direction) (Nearest Town)	sand	72	92
(3) Topography: _____ (Hilly) (Flat) (Level)	tough clay	35	127
(4) Purpose of Well: <u>Industrial</u> (Domestic Irrigation Municipal, Industrial, Other)	sandy shale	32	159
	sandy shale	23	182
Information upon completion of well:	soft sandy shale	21	203
(1) Diameter <u>12"</u> inches.	tough clay	81	284
(2) Total Depth <u>511'</u> feet.	sandy shale-sts. sand	30	314
(3) Water Level <u>70'</u> feet below top of ground.	sand sts clay	23	337
(4) Cased to <u>445'</u> , Size <u>12"</u>	pk sand	23	360
(5) Screen: Size <u>8"</u> , Length <u>55'</u>	pk sand	23	383
(6) Were any formations sealed against pollution? <u>x</u> yes, _____ no.	pk sand	22	405
If YES depth of formation <u>445'</u>	pk sand	23	429
Why <u>Required</u>	pk sand	23	451
Drillers Remarks:	pk sand	24	475
	pk sand	22	497
	pk sand	23	520
	sandy shale-sts sand	22	544
	sandy shale-sts sand	21	565

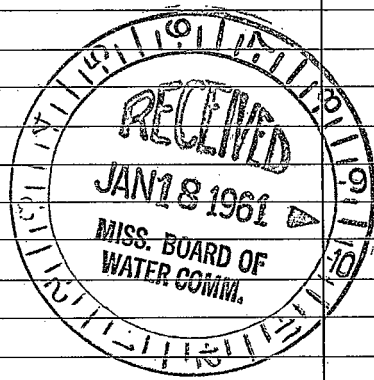

(Use Back Side)

Well No.

