

D 78
7-16-63

WATER WELL DRILLERS LOG

D 78
Washington

Date: July 16, 1963, Driller: Layne-Central Co. County Washington

(#5)

(1) Owner of Land: U. S. Gypsum Co.
(Name)
Greenville, Mississippi
(Address)

(2) Location: 1/4, 1/4, Sec. 3 T. R.
miles of
(distance) (direction) (Nearest Town)

(3) Topography: (Hilly) (Flat) (Level)

(4) Purpose of Well: Industrial
(Domestic Irrigation
Municipal, Industrial, Other)

Information upon completion of well:


- (1) Diameter 18" inches.
- (2) Total Depth 451 feet.
- (3) Water Level 99' feet below top of ground.
- (4) Cased to 390', Size 18"
- (5) Screen: Size 12", Length 50'
- (6) Were any formations sealed against pollution?
 yes, no.

If YES depth of formation 390'

Why required

Drillers Remarks:

Description & Color of Materials Sand, Clay, Red Clay, Shell, etc.	Thick- ness Feet	Depth Feet
clay	15	15
blk. sandy clay	25	40
clay	15	55
sandy clay	30	85
coarse sand gravel	21	106
tough clay	29	135
hard clay (sandy)	110	245
sand	5	250
sandy clay	30	280
rock	1	281
sandy clay	4	285
rock	1	286
tough clay	57	343
sandy clay	34	374
sand draggy sts	12	386
pk. sand	23	409
pk. sand	22	431
pk. sand-draggy sts	13	444
draggy sand-lignite	10	454
sandy shale	59	493
rock	1	494
sandy shale sts. clay	120	614

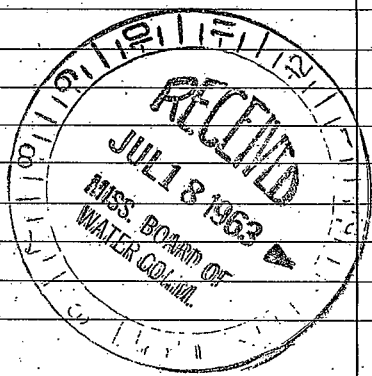

(Use Back Side)

Well No.

