

WASH.
DB1
8-3-61

WATER WELL DRILLERS LOG **CODED**

D

Date: 7/2, 1961, Driller: Boiley Drilling Co. County: Washington
(Name)

(1) Owner of Land: H K Hammett
(Name)
Greenville, Miss.
(Address)

(2) Location: SE 1/4, NE 1/4, Sec. 13 ^N ^W _{T18 R8}
2 miles East of Greenville
(distance) (direction) (Nearest Town)

(3) Topography: Flat
(Hilly) (Flat) (Level)

(4) Purpose of Well:
(Domestic Irrigation
Municipal, Industrial, Other)

Description & Color of Materials Sand, Clay, Red Clay, Shell, etc.	Thick- ness Feet	Depth Feet
<u>Clay</u>	<u>18</u>	<u>18</u>
<u>Sand</u>	<u>67</u>	<u>85</u>
<u>Gravel & Sand</u>	<u>7</u>	<u>92</u>
<u>Mud</u>	<u>215</u>	<u>307</u>
<u>Sand</u>	<u>83</u>	<u>390</u>
<u>Mud</u>	<u>25</u>	<u>415</u>
<u>Sand</u>	<u>87</u>	<u>502</u>

Information upon completion of well:

(1) Diameter 4 x 2 1/2 inches.

(2) Total Depth 500 feet.

(3) Water Level 45 feet below top of ground.

(4) Cased to all way size 4 x 2 1/2.

(5) Screen: Size 2 1/2, Length 30 ft.


(6) Were any formations sealed against pollution?
_____ yes, X no.

If YES depth of formation _____

Why _____

Drillers Remarks: _____

CODED

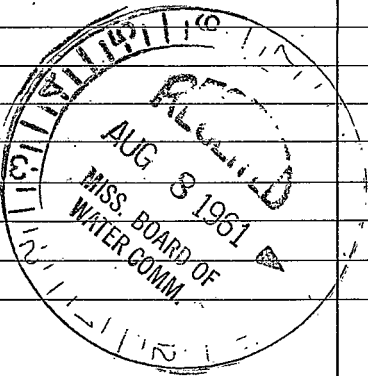

(Use Back Side)

Well No.

