

WASH. D82 12-31-65

MISSISSIPPI BOARD OF WATER COMMISSIONERS

WATER WELL DRILLERS LOG

CODED

Date: 12/31, 1965, Driller: Bailey Drilling Co. County: Washington (Name)

(1) Owner of Land: J.E. Rivers  
 Greenville, Miss.  
 (Name) (Address)

(2) Location: NW 1/4, SW 1/4, Sec. 28 T8R8,  
 1 miles S.E. of Greenville  
 (distance) (direction) (Nearest Town)

(3) Topography: Flat  
 (Hilly) (Flat) (Level)

(4) Purpose of Well: Domestic  
 (Domestic Irrigation Municipal, Industrial, Other)

Description & Color of Materials Sand, Clay, Red Clay, Shell, etc.	Thick-ness Feet	Depth Feet
Clay		30
Sand		80
Gravel		110
Mud		370
Sand + Mud		420
Sand		460
Rock at 393 (6")		

Information upon completion of well:

(1) Diameter 4x3x2 1/2 inches.

(2) Total Depth 460 feet.

(3) Water Level 50 feet below top of ground.

(4) Cased to all way Size 4x3

(5) Screen: Size 2 1/2, Length 25 ft


(6) Were any formations sealed against pollution?  
 yes,  no.

CODED

If YES depth of formation \_\_\_\_\_

Why \_\_\_\_\_

Drillers Remarks: \_\_\_\_\_

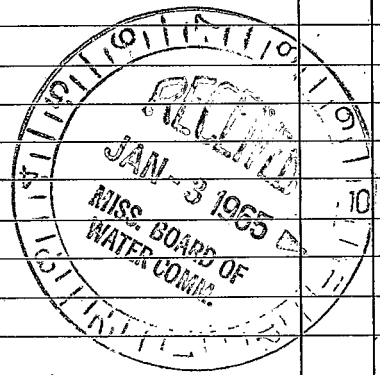

(Use Back Side)

Well No.

