

WASH.

D-300

D86

WATER WELL DRILLERS LOG

8-11-60

Date: 8/11, 1960, Driller: Layne-Central Co. County: Washington

(Name)

(1) Owner of Land: Ray Kuhn (Name) Leland, Mississippi (Address)

(2) Location: 1/4, 1/4, Sec. 27 T 18 R 7 W 4 miles Southeast of Greenville (distance) (direction) (Nearest Town)

(3) Topography: (Hilly) (Flat) (Level)

(4) Purpose of Well: irrigation (Domestic, Irrigation, Municipal, Industrial, Other)

Information upon completion of well:


- (1) Diameter 12" inches.
(2) Total Depth 80'-8" feet.
(3) Water Level 13 feet below top of ground.
(4) Cased to 40'-8" Size
(5) Screen: Size 12", Length 40'
(6) Were any formations sealed against pollution? yes, X no.

If YES depth of formation

Why

Drillers Remarks:

Table with 3 columns: Description & Color of Materials, Thickness Feet, Depth Feet. Rows include Clay, Fine sand, Coarse sand & gravel.

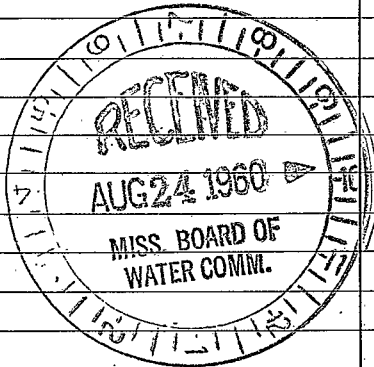

(Use Back Side)

Well No.

Location

28	27
	X
37	38