

WASH.
DB7
10-12-60

info. to locate.
WATER WELL DRILLERS LOG

D?

Date: 10/12, 1960, Driller: Bailey Drilling Co County: Washington
(Name)

(1) Owner of Land: O.L. Dodd Jr
(Name)
Greenville, Miss.
(Address)

(2) Location: 1/4, 1/4, Sec. 35 T R
Hwy 1 South
2 miles South of Greenville
(distance) (direction) (Nearest Town)

(3) Topography: Flat
(Hilly) (Flat) (Level)

(4) Purpose of Well: Domestic
(Domestic Irrigation
Municipal, Industrial, Other)

Description & Color of Materials Sand, Clay, Red Clay, Shell, etc.	Thick- ness Feet	Depth Feet
Clay	20	20
Sand	60	80
Sand + gravel	22	102
Mud	257	359
Sand + Mud	31	390
Mud + rocks	49	439
Mud + Sand	71	460
Sand	73	483

Information upon completion of well:

(1) Diameter 2" inches.


(2) Total Depth 483 feet.

(3) Water Level 43 feet below top of ground.

(4) Cased to bottom, Size 2"

(5) Screen: Size 2", Length 6ft

(6) Were any formations sealed against pollution?
 yes, no.

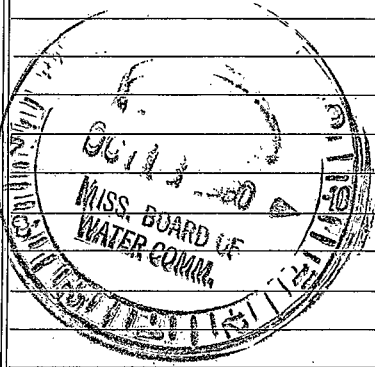

If YES depth of formation _____

Why _____

Drillers Remarks: _____

(Use Back Side)

Well No.

