

D90
9-23-61

WATER WELL DRILLERS LOG

CODED

D 30X

Date: 9/23, 1961, Driller: Bailey Drilling Co (Name) County: Washington

	Description & Color of Materials Sand, Clay, Red Clay, Shell, etc.	Thick- ness Feet	Depth Feet
(1) Owner of Land: <u>Mrs. H. P. Wells</u> (Name) <u>Greenville, Miss.</u> <u>419 S. Main St.</u> (Address) <u>City</u>	<u>Clay</u> <u>Sand</u>	<u>15</u> <u>55</u>	<u>15</u> <u>70</u>
(2) Location: <u>NE 1/4, NW 1/4, Sec. 22, T8R8</u> <u>in Greenville</u> miles (distance) of (Nearest Town)			
(3) Topography: <u>Flat</u> (Hilly) (Flat) (Level)			
(4) Purpose of Well: <u>Fallout shelter</u> (Domestic Irrigation Municipal, Industrial, Other)			

CODED


Information upon completion of well:

- (1) Diameter 2 inches.
- (2) Total Depth 70 feet.
- (3) Water Level 12 feet below top of ground.
- (4) Cased to all way size 2
- (5) Screen: Size 2, Length 6
- (6) Were any formations sealed against pollution?
_____ yes, X no.

If YES depth of formation _____

Why _____

Drillers Remarks: _____

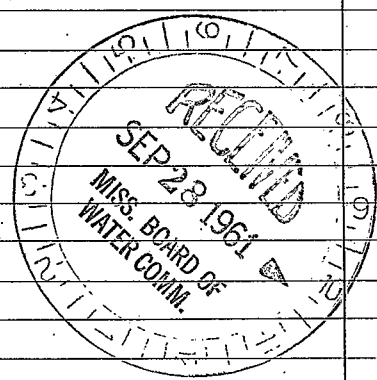

(Use Back Side)

Well No.

