

**CODED** D-305

D91  
9-25-61

WATER WELL DRILLERS LOG

Date: 9/25, 1961, Driller: Biley Drlg. Co. County: Washington  
(Name)

(1) Owner of Land:	Description & Color of Materials Sand, Clay, Red Clay, Shell, etc.	Thick- ness Feet	Depth Feet
<u>Dr. R. L. Montgomery</u> (Name) <u>Greenville, Miss</u> (Address)	<u>Clay</u> <u>Sand</u>	<u>10</u>	<u>10</u>
(2) Location: <u>SE 1/4, SW 1/4, Sec. 22, T8R8</u> <u>in Greenville</u> miles _____ of _____ (distance) (direction) (Nearest Town)			
(3) Topography: <u>Flat</u> (Hilly) (Flat) (Level)			
(4) Purpose of Well: <u>Fallout shelter</u> (Domestic Irrigation Municipal, Industrial, Other)			

**CODED**


Information upon completion of well:

- (1) Diameter 2 inches.
- (2) Total Depth 70 feet.
- (3) Water Level 10 feet below top of ground.
- (4) Cased to all way size 2
- (5) Screen: Size 2, Length 6
- (6) Were any formations sealed against pollution?  
\_\_\_\_\_ yes, X no.

If YES depth of formation \_\_\_\_\_

Why \_\_\_\_\_

Drillers Remarks: \_\_\_\_\_

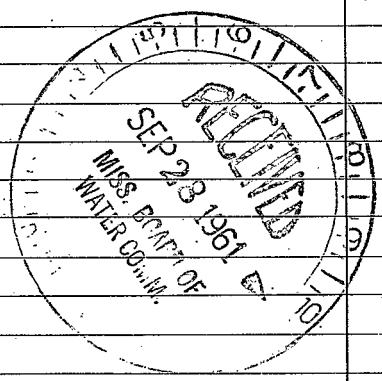

(Use Back Side)

Well No.

