

WASH.  
D 96  
5-1-64

WATER WELL DRILLERS LOG

Date: 5/1, 1964, Driller: Pailey Drilg Co County: Washington  
(Name)

(1) Owner of Land: W E Taylor  
(Name)  
Greenville, Miss.  
(Address)

(2) Location: NW 1/4, SW 1/4, Sec. 31 T    R     
2 miles S, of Greenville  
(distance) (direction) (Nearest Town)

(3) Topography: Flat  
(Hilly) (Flat) (Level)

(4) Purpose of Well: Domestic  
(Domestic Irrigation  
Municipal, Industrial, Other)

Description & Color of Materials Sand, Clay, Red Clay, Shell, etc.	Thick- ness Feet	Depth Feet
<u>Clay</u>		<u>30</u>
<u>Sand</u>		<u>90</u>
<u>Mud</u>		<u>425</u>
<u>Sand</u>		<u>520</u>

Information upon completion of well:

(1) Diameter 4 X 2 inches.

(2) Total Depth 520 feet.

(3) Water Level 47 feet below top of ground.

(4) Cased to all way, Size 4 X 2.


(5) Screen: Size 2, Length 16 ft.

(6) Were any formations sealed against pollution?  
   yes, X no.

If YES depth of formation \_\_\_\_\_

Why \_\_\_\_\_

Drillers Remarks: \_\_\_\_\_

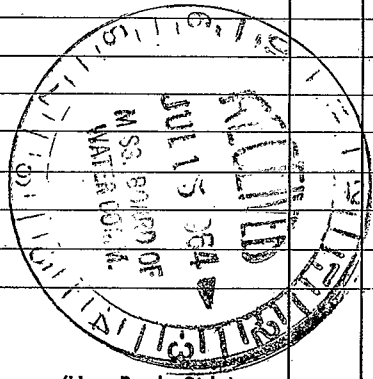

(Use Back Side)

Well No. \_\_\_\_\_

