

Washington
D 99
8-67

MISSISSIPPI
BOARD OF WATER COMMISSIONERS
416 North State Street
Jackson, Mississippi 39201

WATER WELL DRILLERS LOG

Aug 17 1967 Schultz Drilling Co Washington
date well completed firm name county well located


LANDOWNER: E. T. Fitts
Highway 1, South
Drewville Miss
(mailing address)

WELL LOCATION:
sec. 34 T. 18 N. R. 8 E
S
1/2 miles South of Drewville
(distance) (direction) (nearest town)

WELL PURPOSE: Home
(home, irrigation, municipal, industrial)

- WELL COMPLETION DATA:
- (1) diameter (inches) 2"
 - (2) total depth (feet) 472
 - (3) static water level (feet) 59 below top of ground.
 - (4) casing Galv. 462 (material) (depth)
 - (size) If telescope see back.
 - (5) screen 10 (length) (depth to top)
 - 2" Stainless (size) (material)
 - (6) pump 1 (HP) 6 (yield gpm)
 - 6/6 (type power)
 - (7) electric log No (yes or no)
 - (organization running log)
 - (8) how well bottom plugged P.N

description of formations encountered	from	to
Clay	0	22
Sand	22	97
Clay	97	135
Sand	135	140
Sand & Shale & Clay	140	360
Fine Sand	360	380
Clay & Shale	380	440
Sand	440	472

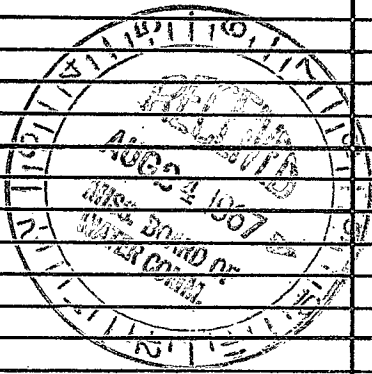

DRILLERS REMARKS:
Five Sand
Slow Return

