

D 107
4-24-63

D 107

WATER WELL DRILLERS LOG

Date: 4/24, 1963, Driller: Boyle Drlg Co County: Washington
(Name)


(1) Owner of Land:	Description & Color of Materials Sand, Clay, Red Clay, Shell, etc.	Thick- ness Feet	Depth Feet
<u>U S Government</u> (Name)			
<u>Greenville Midstream Service</u> (Address)	<u>Clay</u>		<u>30</u>
(2) Location: <u>1/4</u> , <u>1/4</u> , Sec <u>13 18N 9W</u> T R	<u>Sand</u>		<u>60</u>
<u>4</u> miles <u>SW</u> of <u>Greenville</u> (distance) (direction) (Nearest Town)	<u>Charol</u>		<u>90</u>
(3) Topography: <u>Flat</u> (Hilly) (Flat) (Level)	<u>Mud</u>		<u>430</u>
(4) Purpose of Well: <u>Commercial</u> (Domestic, Irrigation, Municipal, Industrial, Other)	<u>Sand</u>		<u>470</u>

Information upon completion of well:

- (1) Diameter 4 x 2 1/2 inches.
- (2) Total Depth 470 feet.
- (3) Water Level 45 feet below top of ground.
- (4) Cased to all way Size 4 x 2 1/2
- (5) Screen: Size 2 1/2, Length 30ft
- (6) Were any formations sealed against pollution?
 yes, no.

Insuff info
to locate

If YES depth of formation _____
Why _____
Drillers Remarks: _____

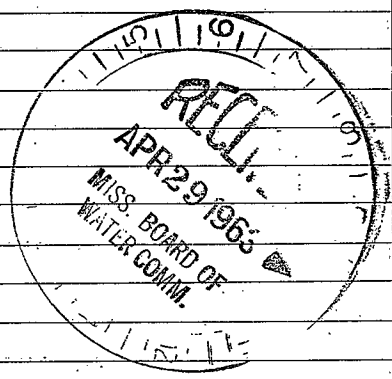

(Use Back Side)

Well No.

2 10 10 10 10 10