

WASH.

MISSISSIPPI BOARD OF WATER COMMISSIONERS

D 108

6-19-63

WATER WELL DRILLERS LOG

CODED

Date: 6/19, 1963, Driller: Bailey Drlg Co Washington (Name)

(1) Owner of Land: T T Latham (Name) Leland, Miss. (Address)

(2) Location: 1/4, 1/4, Sec. 30 18N 7W T R, 1 1/2 miles SE of Greenville (distance) (direction) (Nearest Town)

(3) Topography: Flat (Hilly) (Flat) (Level)

(4) Purpose of Well: Domestic (Domestic Irrigation Municipal, Industrial, Other)

Description & Color of Materials Sand, Clay, Red Clay, Shell, etc.	Thick- ness Feet	Depth Feet
Clay		45
Sand		73
Gravel		90
Mud		391
Sand		430

Information upon completion of well:

(1) Diameter 2 1/2 x 2 inches.

(2) Total Depth 430 feet.

(3) Water Level 35 feet below top of ground.

(4) Cased to all way size 2 1/2 x 2


(5) Screen: Size 2, Length 10ft.

(6) Were any formations sealed against pollution? yes, X no.

If YES depth of formation

Why

Drillers Remarks:

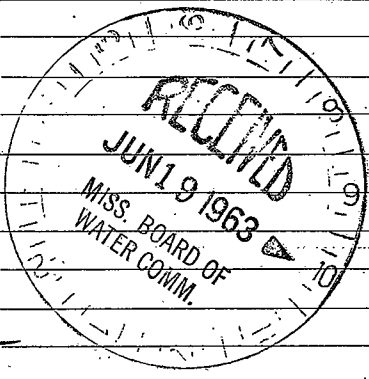

CODED

Insuff. info to locate

Well No.

(Use Back Side)

