

WASH.
D 109
1-9-63

MISSISSIPPI BOARD OF WATER COMMISSIONERS

WATER WELL DRILLERS LOG CODED

CODED

Date: 1/9, 1963, Driller: Boiley Drilling Co County: Washington
(Name)

(1) Owner of Land	Description & Color of Materials Sand, Clay, Red Clay, Shell, etc.	Thick- ness Feet	Depth Feet
<u>Junior Henderson</u> (Name) <u>Greenville</u> (Address)	<u>Clay</u> <u>Sand</u>	<u>40</u> <u>26</u>	<u>40</u> <u>66</u>
(2) Location: <u>1/4</u> , <u>1/4</u> , Sec. <u>3</u> <u>18W 8N</u> T <u> </u> R <u> </u> <u>In Greenville</u> miles <u> </u> of <u> </u> , (distance) (direction) (Nearest Town)			
(3) Topography: <u>Flat</u> (Hilly) (Flat) (Level)			
(4) Purpose of Well: <u>domestic</u> (Domestic Irrigation Municipal, Industrial, Other)			

Information upon completion of well:

- (1) Diameter 2 inches.
- (2) Total Depth 66 feet.
- (3) Water Level 12 feet below top of ground.
- (4) Cased to all way Size 2
- (5) Screen: Size 1/4" Length 3 ft
- (6) Were any formations sealed against pollution?
 yes, X no.


If YES depth of formation _____

Why _____

Drillers Remarks: _____

CODED

Insuff. info.
to locate

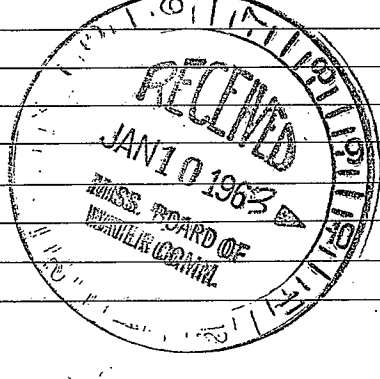

(Use Back Side)

Well No.

