

WASH.

D III

CODED

D 302

WATER WELL DRILLERS LOG

Date: 7-10-61, 1961, Driller: Bailey Drilling Co. County: Washington (Name)

(1) Owner of Land: Arthur Pickers
(Name)
Greenville, Miss.
(Address)

(2) Location: 34 18 N 8 W 34 18 N 8 W T R.
2 miles South of Greenville
(distance) (direction) (Nearest Town)

(3) Topography: Flat
(Hilly) (Flat) (Level)

(4) Purpose of Well: Domestic
(Domestic Irrigation, Municipal, Industrial, Other)

Description & Color of Materials Sand, Clay, Red Clay, Shell, etc.	Thick- ness Feet	Depth Feet
<u>Clay</u>	<u>18</u>	<u>18</u>
<u>Sand</u>	<u>22</u>	<u>40</u>
<u>Gravel + Sand</u>	<u>25</u>	<u>105</u>
<u>Mud</u>	<u>380</u>	<u>485</u>
<u>Sand</u>	<u>27</u>	<u>512</u>

CODED

Information upon completion of well:

(1) Diameter: 4 X 2 inches.

(2) Total Depth: 570 feet.

(3) Water Level: 42 feet below top of ground.

(4) Cased to: all way, Size 4 X 2.

(5) Screen: Size 2, Length 10 ft.

(6) Were any formations sealed against pollution?
_____ yes, X no.


Rocks at 380, 420, 450, and 462

Insufficient info to locate

If YES depth of formation _____

Why _____

Drillers Remarks: _____

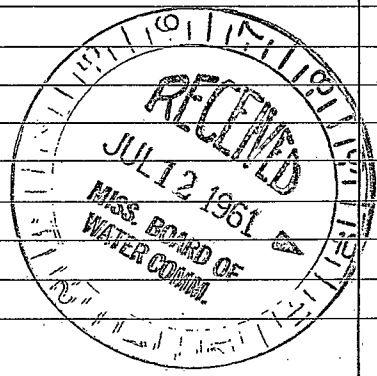

(Use Back Side)

Well No.

