

Memphis

Washington
D113
3-18-69

MISSISSIPPI
BOARD OF WATER COMMISSIONERS CODED
416 North State Street
Jackson, Mississippi 39201

WATER WELL DRILLERS LOG

March 18, 1969 Layne-Central Co. Washington
date well completed firm name county well located

LANDOWNER:

City of Greenville

Greenville, Mississippi
(mailing address)

description of formations encountered

from to

Clay	0	5
sand	5	30
sand & gravel	30	96
rock & clay st.	96	130
hard clay	130	310
sandy clay & rocks	310	355
hard clay & rock	355	400
sandy clay	400	425
sand mixed clay	425	546
sand	546	568
fine sand-mixed clay	568	672
hard clay	672	683

WELL LOCATION:

sec 11 T 18 N R 8 E
2 S W
miles of (distance) (direction) (nearest town)

WELL PURPOSE: municipal
(home, irrigation, municipal, industrial)

WELL COMPLETION DATA:

- (1) diameter (inches) 18"
- (2) total depth (feet) 666'
- (3) static water level (feet) 76' below above top of ground.
- (4) casing steel 585'
(material) (depth)
18"
(size) If telescope see back.
- (5) screen 79' 590'
(length) (depth to top)
12" stainless steel
(size) (material)
- (6) pump 150 1200
(HP) (yield gpm)
electric
(type power)
- (7) electric log USGS #66
(yes or no)
100-680
(organization running log)
- (8) how well bottom plugged _____


APR 17 1969

DRILLERS REMARKS:

MISS. BD. OF
WATER COMMISSIONERS

If well telescopes please sketch and show depths.

GROUND LEVEL

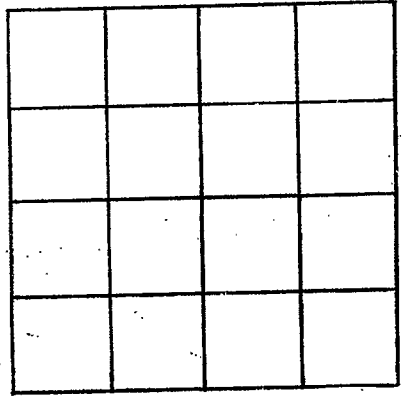

SECTION _____

Please indicate well location X.

ADDITIONAL INFORMATION

If more than one screen, show locations of each on sketch.