

WASHINGTON
D 116
3-13-71

MISSISSIPPI
BOARD OF WATER COMMISSIONERS
416 North State Street
Jackson, Mississippi 39201

CODED

WATER WELL DRILLERS LOG

3-13 1971
date well completed

Schultz Drilling
firm name

Washington
county well located

LANDOWNER: <u>Alphonso O. Thomas</u>	description of formations encountered	from	to
<u>Greenville Miss</u> (mailing address)	<u>Clay</u>	<u>0</u>	<u>17</u>
	<u>Sand</u>	<u>17</u>	<u>96</u>
WELL LOCATION: sec <u>34</u> T <u>18</u> N R <u>8 E</u> <u>1</u> miles <u>S</u> of <u>Greenville</u> (distance) (direction) (nearest town)	<u>Clay</u>	<u>96</u>	<u>161</u>
	<u>Sand</u>	<u>161</u>	<u>170</u>
WELL PURPOSE: <u>Home</u> (home, irrigation, municipal, industrial)	<u>Clay</u>	<u>170</u>	<u>200</u>
	<u>Sandy Shale</u>	<u>200</u>	<u>241</u>
WELL COMPLETION DATA: (1) diameter (inches) <u>2"</u>	<u>Sand & shale</u>	<u>24</u>	<u>310</u>
(2) total depth (feet) <u>514</u>	<u>Sand</u>	<u>310</u>	<u>340</u>
(3) static water level (feet) <u>58</u> below top of ground.	<u>Sandy Shale</u>	<u>340</u>	<u>362</u>
(4) casing <u>CW</u> (material) (depth)	<u>Sand</u>	<u>362</u>	<u>420</u>
<u>NO</u> if telescope see back. (size)	<u>Rock</u>	<u>420</u>	<u>421</u>
(5) screen <u>10</u> (length) (depth to top)	<u>Sand</u>	<u>421</u>	<u>462</u>
<u>2"</u> (size) <u>Screen</u> (material)	<u>Clay</u>	<u>463</u>	<u>468</u>
(6) pump <u>1</u> (HP) <u>12</u> (yield gpm)	<u>Sand</u>	<u>468</u>	<u>575</u>
<u>Electric</u> (type power)			
(7) electric log <u>NO</u> (yes or no)			
(organization running log) <input checked="" type="checkbox"/>			
(8) how well bottom plugged <u>Spook</u>			
DRILLERS REMARKS:			


CODED

MAR 30 1971

MISS. BD. OF
WATER COM.

If well telescopes please sketch and show depths.

GROUND LEVEL

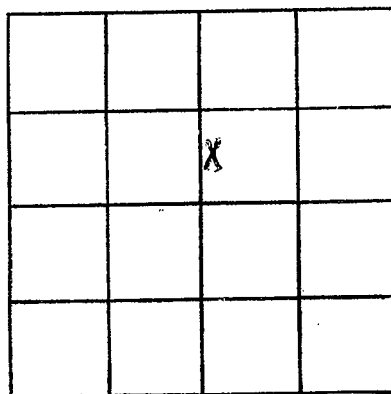

SECTION _____

Please indicate well location X.

ADDITIONAL INFORMATION

If more than one screen,
show locations of each on sketch.