

WASHINGTON
 D 117
 5-17-71

MISSISSIPPI
 BOARD OF WATER COMMISSIONERS
 416 North State Street
 Jackson, Mississippi 39201
 Owens *Plbg. & Heating*
 WATER WELL DRILLERS LOG

CODED

5/17 1971 *Friedman Metal & Steel*
 date well completed *City* firm name county well located *Wash.*

LANDOWNER: *W. Friedman*
Friedman Steel Co.
Greenville, Miss
 (mailing address)

description of formations encountered	from	to
<i>top soil</i>		<i>20</i>
<i>Sand + gravel</i>	<i>20</i>	<i>120</i>
<i>Clay + Rocks</i>	<i>120</i>	<i>180</i>
<i>pond</i>	<i>180</i>	<i>200</i>

WELL LOCATION:
 sec. *21* T. *18* N. R. *8* E
City miles of *Guille*
 (distance) (direction) (nearest town)

WELL PURPOSE:
 (home, irrigation, municipal, industrial)

WELL COMPLETION DATA:

(1) diameter (inches) *4 1/2*

(2) total depth (feet) *520*

(3) static water level (feet) *60* below above top of ground.

(4) casing *galv.* *500*
 (material) (depth)

(size) If telescope see back.

(5) screen *20'* *500*
 (length) (depth to top)

2" *S.S.*
 (size) (material)

(6) pump *12* *50*
 (HP) (yield gpm)

ELEC
 (type power)

(7) electric log _____
 (yes or no)

(organization running log)


(8) how well bottom plugged *B.W.*

CODED

DRILLERS REMARKS:
Owens

If well telescopes please sketch and show depths.

GROUND LEVEL

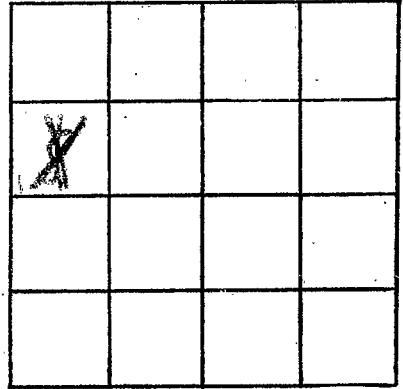

SECTION _____

Please indicate well location X.

ADDITIONAL INFORMATION

If more than one screen, show locations of each on sketch.

Handwritten signature or initials