

WASHINGTON

D 118

6-14-71

MISSISSIPPI
BOARD OF WATER COMMISSIONERS
416 North State Street
Jackson, Mississippi 39201

CODED

WATER WELL DRILLERS LOG

June 14, 1971 SINGER-Layne Central Division Washington
date well completed firm name county well located

LANDOWNER: Clarke Reed
Greenville, Mississippi

(mailing address)

WELL LOCATION:

sec. 35 T. 18 N R. 8 ~~Ex~~ W
Baylor Road of Greenville
(distance) miles (direction) of (nearest town)

WELL PURPOSE: home
(home, irrigation, municipal, industrial)

WELL COMPLETION DATA:

(1) diameter (inches) 4
(2) total depth (feet) 462' 2"
(3) static water level (feet) 62' 8" below
top of ground.

(4) casing steel, 419' 9"
(material) (depth)
4" if telescope see back.
(size)

(5) screen 31' 1", 450' 10"
11' 4" of 4" I.P.F. (length) (depth to top)
4" stainless steel
(size) (material)

(6) pump 3 50
(HP) (yield gpm)
electric
(type power)

(7) electric log no
(yes or no)

(organization running log)

(8) how well bottom plugged shot
100 lbs.

| description of formations encountered | from | to |
|---------------------------------------|------|-----|
| Clay | 0 | 14 |
| Fine sand | 14 | 35 |
| Coarse sand | 35 | 60 |
| Coarse sand & pea gravel | 60 | 81 |
| Clay | 81 | 245 |
| Sand & strks. clay | 245 | 276 |
| Sand | 276 | 280 |
| Sand & strks. clay | 280 | 355 |
| Shale & sand strks. | 355 | 389 |
| Clay | 389 | 411 |
| Sand | 411 | 462 |

CODED


JUN 17 1971

MISS. BD. OF
WATER COMM.

DRILLERS REMARKS:

If well telescopes please sketch and show depths.

GROUND LEVEL

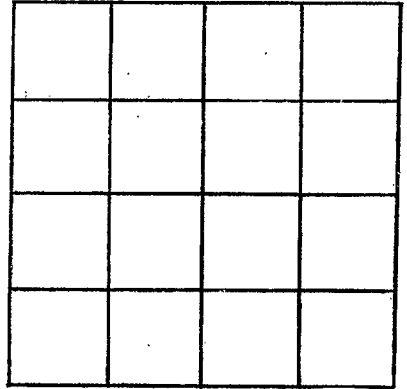

SECTION _____

Please indicate well location X.

ADDITIONAL INFORMATION

If more than one screen,
show locations of each on sketch.