

WASHINGTON
 D119
 6-15-71

MISSISSIPPI
 BOARD OF WATER COMMISSIONERS
 416 North State Street
 Jackson, Mississippi 39201

CODED

WATER WELL DRILLERS LOG

6-15-1971 date well completed Schultz Drilling & Washington firm name Washington county well located

LANDOWNER:
 Greenville Christian School
 Greenville, Miss
 (mailing address)

description of formations encountered	from	to
Clay	0	24
Sand	24	90

WELL LOCATION:
 sec 35 T 18 N R 8 E
1 miles 5 of Bill
 (distance) (direction) (nearest town)

Clay	90	224
Shale	224	305

WELL PURPOSE: School
 (home, irrigation, municipal, industrial)

Sand + shale	305	425
--------------	-----	-----

WELL COMPLETION DATA:

Hard Shale	425	445
------------	-----	-----

- (1) diameter (inches) 4 X 2 1/2
- (2) total depth (feet) 538
- (3) static water level (feet) 57 below top of ground.
- (4) casing Galv (material) (depth)

Clay + Shale	445	506
Sand	506	538

(size) if telescope see back.

CODED

- (5) screen 30 (length) (depth to top)
2 1/2 (size) Stainless (material)

- (6) pump 5 (HP) 70 (yield gpm)
elec (type power)

- (7) electric log no (yes or no)

JUL 9 1971

(organization running log)


- (8) how well bottom plugged perfect

MISS. BD. OF WATER COMMISSIONERS

DRILLERS REMARKS:

If well telescopes please sketch and show depths.

GROUND LEVEL

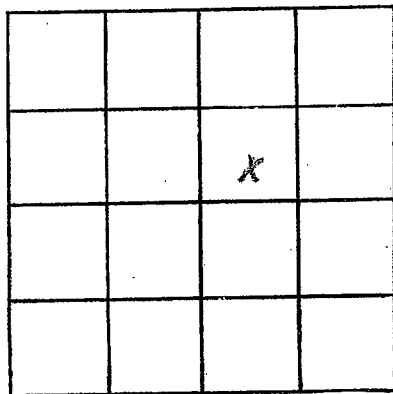

SECTION 35

Please indicate well location X.

ADDITIONAL INFORMATION

If more than one screen, show locations of each on sketch.