

WASHINGTON
D120
7-6-71

MISSISSIPPI
BOARD OF WATER COMMISSIONERS
416 North State Street
Jackson, Mississippi 39201

CODED

WATER WELL DRILLERS LOG

7-6 1971 Schulte Drilling Co Washington
date well completed firm name county well located

LANDOWNER: <u>Collette Boone</u> (Baller)	description of formations encountered	from	to
<u>Greenville, Miss</u> (mailing address)	Clay	0	23
WELL LOCATION: sec <u>26</u> T <u>N</u> R <u>8</u> E W <u>4</u> miles <u>E</u> of <u>Greenville</u> (distance) (direction) (nearest town)	Sand	23	86
WELL PURPOSE: <u>Home</u> (home, irrigation, municipal, industrial)	Clay	86	153
WELL COMPLETION DATA: (1) diameter (inches) <u>2"</u>	Sandy Silt	153	244
(2) total depth (feet) <u>472</u>	Clay	244	253
(3) static water level (feet) <u>57</u> below top of ground.	Sand clay streak	253	382
(4) casing <u>Cu</u> (material) (depth)	Clay	382	384
(size) If telescope see back.	Sand	384	391
(5) screen <u>10</u> (length) (depth to top)	Clay	391	393
<u>2"</u> <u>stainless</u> (size) (material)	Sand	393	486
(6) pump <u>1</u> <u>10</u> (HP) (yield gpm)			
<u>etc</u> (type power)			
(7) electric log <u>NO</u> (yes or no)			
(organization running log)			
(8) how well bottom plugged <u>Spaced</u>			
DRILLERS REMARKS:			


CODED

JUL 9 1971

MISS. BD. OF
WATER COM.

If well telescopes please sketch and show depths.

GROUND LEVEL

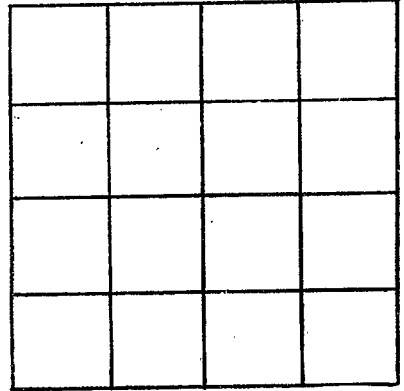

SECTION _____

Please indicate well location X.

ADDITIONAL INFORMATION

If more than one screen, show locations of each on sketch.