

WASHINGTON
D122
10-23-71

MISSISSIPPI
BOARD OF WATER COMMISSIONERS
416 North State Street
Jackson, Mississippi 39201

WATER WELL DRILLERS LOG

CODED

23 Oct 1971 Lambert Drilling Co Wash
date well completed firm name county well located

LANDOWNER:
Americal Regial
Greenville, Miss.
(mailing address)

WELL LOCATION:
sec. 3 T. 18 N R. 8 W
3 miles n of Greenville
(distance) (direction) (nearest town)

WELL PURPOSE: Home
(home, irrigation, municipal, industrial)

WELL COMPLETION DATA:

(1) diameter (inches) 4 X 2
(2) total depth (feet) 435
(3) static water level (feet) 78 below above top of ground.
(4) casing galv. 425 (material) (depth) 4 X 2 (size) If telescope see back.
(5) screen 10' (length) 435-425 (depth to top) 2 1/2" (size) SS. (material)
(6) pump 3/4 (HP) 15 (yield gpm) Elect. (type power)
(7) electric log (yes or no)
(organization running log)
(8) how well bottom plugged back wash valve.

description of formations encountered	from	to
mixed	0	20
sand	20	50
sand & gravel	50	70
sand	70	105
gravel	105	112
clay	112	160
sand & clay st.	160	284
Rock	284	285
sand & clay st	285	335
Rock	335	336
clay	336	340
Rock	340	341
clay	341	347
Rock	347	348
sand & clay st.	348	405
sand	405	460

CODED

OCT 23 1971

DRILLERS REMARKS:

MISS DP DE
UNITED STATES

If well telescopes please sketch and show depths.

GROUND LEVEL

147

411


425

2' 1"

435

2 1/2 Screen

If more than one screen, show locations of each on sketch.

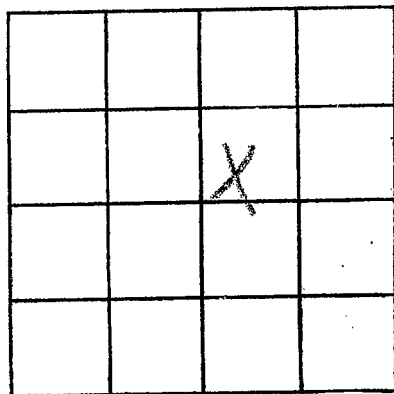

SECTION 3

Please indicate well location X.

ADDITIONAL INFORMATION

Lined area for additional information.