

WASHINGTON
 D131
 9-1-72

MISSISSIPPI
 BOARD OF WATER COMMISSIONERS
 416 North State Street
 Jackson, Mississippi 39201

CODED

WATER WELL DRILLERS LOG


9-1 1972 *W. Schultz Drilling* firm name *Washington* county well located

LANDOWNER: <i>Daug Abernethy</i>	description of formations encountered	from to
<i>Greenville, Miss</i> (mailing address)	<i>Clay</i>	<i>0 18</i>
WELL LOCATION: sec <i>35</i> T <i>18</i> N R <i>8</i> E <i>1/2</i> miles <i>ES</i> of <i>Cl</i> (distance) (direction) (nearest town)	<i>Sand</i>	<i>18 65</i>
WELL PURPOSE: <i>Home</i> (home, irrigation, municipal, industrial)		
WELL COMPLETION DATA:		
(1) diameter (inches) <i>2"</i>		
(2) total depth (feet) <i>65</i>		
(3) static water level (feet) <i>16</i> below above top of ground.		
(4) casing <i>PVC</i> , <i>60</i> (material) (depth)		
(size) If telescope see back.		
(5) screen <i>5</i> (length) (depth to top)		
<i>2"</i> (size) <i>PVC</i> (material)		
(6) pump <i>None</i> (HP) (yield gpm)		
(type power)		
(7) electric log <i>—</i> (yes or no)		
(organization running log)		
(8) how well bottom plugged <i>Plug</i>		
DRILLERS REMARKS:	FEB 5 1973	

CODED

If well telescopes please sketch and show depths.

GROUND LEVEL

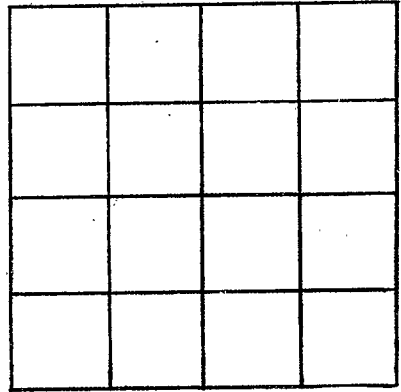

SECTION _____

Please indicate well location X.

ADDITIONAL INFORMATION

If more than one screen, show locations of each on sketch.