

WASH
D 135
4-10-73

MISSISSIPPI
BOARD OF WATER COMMISSIONERS
416 North State Street
Jackson, Mississippi 39201

CODED

WATER WELL DRILLERS LOG

10 Nov 1973 Lambert Drilling Wash
date well completed firm name county well located

LANDOWNER:
B. A. H. K. I. I.
Hog 82 E. Greenville, Miss.
(mailing address)

WELL LOCATION:
sec. 15 T. 18 N R. 8 E
5 miles E of Greenville
(distance) (direction) (nearest town)

WELL PURPOSE: none.
(home, irrigation, municipal, industrial)

WELL COMPLETION DATA:
(1) diameter (inches) 2"
(2) total depth (feet) 420'
(3) static water level (feet) 42 below top of ground.
(4) casing P.V.C. 410 (material) (depth) (size) if telescope see back.
(5) screen 10' 420-410 (length) (depth to top) 2" P.V.C. (size) (material)
(6) pump 1 (HP) 10 (yield gpm) Elect. (type power)
(7) electric log no (yes or no)
(organization running log)
(8) how well bottom plugged: P.V.C. back wash valve.

description of formations encountered	from	to
Clay	0	40
sand.	40	60
Clay	60	130
Clay & Sand SE.	130	264
Rock	264	268
Clay & Sand SE.	268	315
Sand.	315	330
Sand. CODED	330	360
Sand. grad.	360	420


APR 20 1973

DRILLERS REMARKS:

MIS.
WA.

If well telescopes please sketch and show depths.

GROUND LEVEL

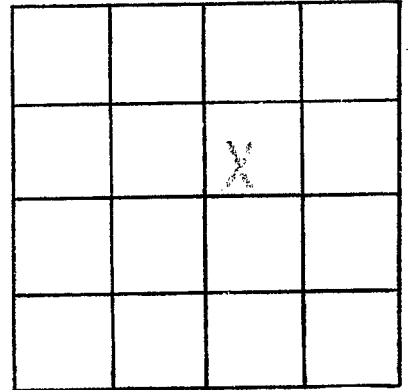

SECTION 15

Please indicate well location X.

ADDITIONAL INFORMATION

If more than one screen, show locations of each on sketch.