

WASH.  
D 136  
7-31-73

MISSISSIPPI  
BOARD OF WATER COMMISSIONERS  
416 North State Street  
Jackson, Mississippi 39201

WATER WELL DRILLERS LOG

date well completed 19 7-31-73 firm name Owens P/B + W.W.D. county well located Wash

LANDOWNER: VINER

128 So W 1/2 N 1/4 S 1  
Greenville, Miss.  
(mailing address)

description of formations encountered

from to

top - soil	0	15
clay	15	36
sand	36	84

WELL LOCATION:

Lot 13 BLK. ORIGINAL Add.  
Sec 22 T 14 N 18 R 8 E  
City of Greenville  
(distance) (direction) (nearest town)

WELL PURPOSE: Commercial  
(home, irrigation, municipal, industrial)

WELL COMPLETION DATA:

- (1) diameter (inches) 2"
- (2) total depth (feet) 84
- (3) static water level (feet) 30 below above top of ground.
- (4) casing Galv. 79'  
(material) (depth)
- (size) If telescope see back.
- (5) screen 5' 84'  
(length) (depth to top)
- 2" Brass  
(size) (material)
- (6) pump 12  
(HP) (yield gpm)
- Elec.  
(type power)
- (7) electric log NO  
(yes or no)

(organization running log)


(8) how well bottom plugged SB

DRILLERS REMARKS: Owens

AUG 3 1973

If well telescopes please sketch and show depths.

GROUND LEVEL

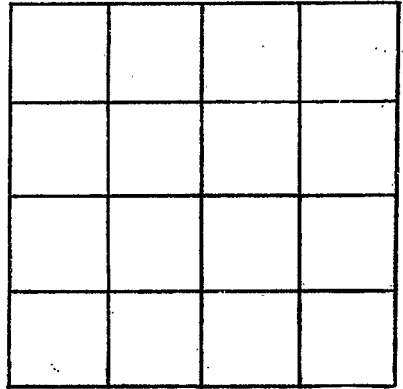

SECTION \_\_\_\_\_

Please indicate well location X.

ADDITIONAL INFORMATION

If more than one screen, show locations of each on sketch.