

D 137
WASHINGTON
8-10-73

MISSISSIPPI
 BOARD OF WATER COMMISSIONERS
 416 North State Street
 Jackson, Mississippi 39201

CODED

WATER WELL DRILLERS LOG

Aug 10 1973 Queens Plumbing Wash
 date well completed firm name county well located

LANDOWNER: W. D. Jackson
P.O. Box 4426
Greenville, Mo, 38761
 (mailing address)

description of formations encountered	from	to
top soil	0	30
Sand & gravel	30	100
Sand	100	163
Clay	163	193
Sand	193	356

WELL LOCATION:
 sec 16 T 18 N R 8 E
~~North~~ miles 2 of Greenville
 (distance) (direction) (nearest town)

CODED

WELL PURPOSE:
 (home, irrigation, municipal, industrial)


- WELL COMPLETION DATA:
- (1) diameter (inches) 2"
 - (2) total depth (feet) 356'
 - (3) static water level (feet) 30 below above top of ground.
 - (4) casing galv. 336'
 (material) (depth)
 (size) if telescope see back.
 - (5) screen 20' 356'
 (length) (depth to top)
2" S.S.
 (size) (material)
 - (6) pump 1 12
 (HP) (yield gpm)
Electric
 (type power)
 - (7) electric log no
 (yes or no)
 - (organization running log)
 - (8) how well bottom plugged S.B.

DRILLERS REMARKS: Queens

AUG 20 1973

If well telescopes please sketch and show depths.

GROUND LEVEL

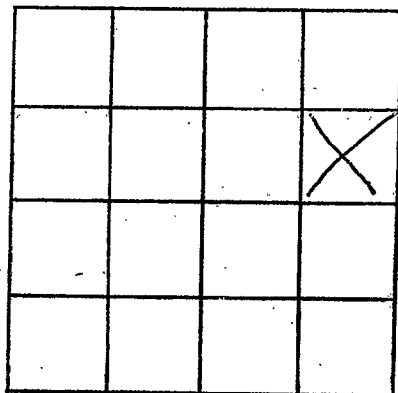

SECTION _____

Please indicate well location X.

ADDITIONAL INFORMATION

If more than one screen, show locations of each on sketch.