

WASH.
D 142
5-20-74

MISSISSIPPI
BOARD OF WATER COMMISSIONERS CODED
416 North State Street
Jackson, Mississippi 39201

WATER WELL DRILLERS LOG

5/20 1974 date well completed
T.F. Bailey Drilling Co. firm name
Washington county well located

LANDOWNER: H.K. Hammett
Greenville
Miss.
(mailing address)

description of formations encountered	from to	
	feet	feet
Clay	0	18
Sand	18	85
Gravel	85	92
Mud	92	307
Sand	307	390
Mud	390	415
Sand	415	500

WELL LOCATION:
sec. 13 T. 18 N. R. 8 W.
4 miles NE of Greenville
(distance) (direction) (nearest town)

WELL PURPOSE: Home
(home, irrigation, municipal, industrial)

WELL COMPLETION DATA:

- (1) diameter (inches) 4 X 2 1/2
- (2) total depth (feet) 500
- (3) static water level (feet) 57 below top of ground.
- (4) casing steel, 485' (material) (depth)
4 X 2 if telescope see back. (size)
- (5) screen 15' length, 485' depth to top, 2 1/2" Stainless Steel (size) (material)
- (6) pump 2 HP, 30 gpm yield (HP) (yield gpm)
Electric (type power)
- (7) electric log No (yes or no)

(organization running log)

(8) how well bottom plugged
Back pressure Valve

DRILLERS REMARKS:


CODED

RECEIVED
MAY 20 1974

MISS. BD. OF WATER COMMISSIONERS

If well telescopes please
sketch and show depths.

GROUND LEVEL

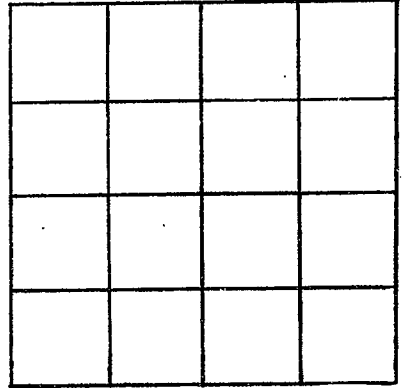

SECTION _____

Please indicate well location X.

ADDITIONAL INFORMATION

If more than one screen,
show locations of each on sketch.