

MISSISSIPPI
BOARD OF WATER COMMISSIONERS
416 North State Street
Jackson, Mississippi 39201

CODED

WATER WELL DRILLERS LOG

WASH.
D 143
5-30-74

5/30 1974 date well completed
Bailey Drilling Co firm name
Washington county well located

LANDOWNER: Waterways Marine
Greenville, Miss
(mailing address)

description of formations encountered	from to	
Clay	0	30
Sand	30	75
Gravel	75	85
Mud	85	320
Sand	320	385

WELL LOCATION
sec. 13 T. 11N. R. 9W.
5 miles SW of Greenville
(distance) (direction) (nearest town)

WELL PURPOSE: Industrial
(home, irrigation, municipal, industrial)

WELL COMPLETION DATA:

- (1) diameter (inches) 6 X 4 X 3
- (2) total depth (feet) 385
- (3) static water level (feet) 50 below above top of ground.
- (4) casing Steel, 355,
(material) (depth)
6 X 4 if telescope see back.
(size)
- (5) screen 30, 355
(length) (depth to top)
3", Stainless Steel
(size) (material)
- (6) pump 10 110
(HP) (yield gpm)
Electric
(type power)
- (7) electric log No.
(yes or no)

CODED

(organization running log)

(8) how well bottom plugged
Back pressure valve

DRILLERS REMARKS:


MAY 20 1974

MISSISSIPPI WATER COMMISSION

If well telescopes please sketch and show depths.

GROUND LEVEL

Handwritten notes:
5' 0" - 10' 0"
10' 0" - 15' 0"
15' 0" - 20' 0"

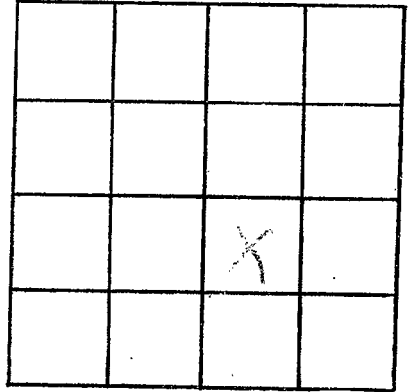

SECTION 10

Please indicate well location X.

ADDITIONAL INFORMATION

Lined area for additional information.

If more than one screen, show locations of each on sketch.